



3010 Gaylord Parkway  
Suite 190  
Frisco, TX 75034  
TEL 972.377.7480  
FAX 972.377.8380  
[www.GarverUSA.com](http://www.GarverUSA.com)

**June 6, 2023**

**2306ANDRW - Addendum No. 2  
To Contract Documents and Plans**

**Andrews County Airport (E11)  
Runway 16-34 and Taxiway A Reconstruction  
TxDOT CSJ No. 2306ANDRW**

This addendum shall be a part of the Plans, Contract Documents and Specifications to the same extent as though it were originally included therein, and it shall supersede anything contained in the Plans, Contract Documents, and Specifications with which it might conflict. This addendum, including all attachments, shall become part of the Contract and all provisions of the Contract shall apply thereto. The time provided for completion of the Contract has not been changed as noted in this addendum. Acknowledgement of receipt of this Addendum must be provided on TxDOT Bid Form page 7 included in the Contract Documents.

**Questions asked before June 6<sup>th</sup>, 2023 include:**

1. Detail 1 on Sheet CP-005 says that the soil material used to fill the void caused by the removal of existing asphalt and base will be subsidiary to P-101. Can you verify that this quantity is not included in the 8,994 C.Y. of Embankment shown for Schedule 1?
  - Detail 1 on Sheet CP-005 was updated in this Addendum to read, "shall be paid for under P-152." The quantity was calculated within the 8,994 C.Y. of embankment for Schedule 1.
2. In Specification Section 152-2.3 Borrow Excavation, it states that "Caliche base course material obtained from on-site pavement demolition operations may be utilized as select fill beneath pavements, embankment construction, or undercut backfill" If that is the case, in areas where pavement is removed and no new-pavement section constructed (south end of runway, Taxiway G, Taxiway 11 Ext), can the existing base be left in place and only the asphalt pavement be removed?
  - The existing base may be left in-place in areas where the pavement is to be removed but where no new pavement is to be reconstructed. The contractor will be responsible for 4-inches of topsoil, seeding/sodding, and establishing the proposed grades in these areas.
3. Shouldn't Schedule 2 have a Full Depth Asphalt Pavement Removal Item for the removal of the existing Taxiway G?
  - The Full Depth Asphalt Pavement Removal Item for Schedule 2 for Taxiway G was calculated to be 2,787 S.Y. and has been updated on the Bid Form of this Addendum.
4. Will the engineer's estimate be provided to bidders?
  - No, the engineer's opinion of probable cost was not provided. However, the overall estimate totals for the Base Bid and Additive Alternate 1 are provided on the TxDOT Aviation Bidder's List.

**Revisions or additions made to the Contract Documents and Plans:**

**Bid Form**

1. Added Pay Item D-701-5.2 12" Reinforced Concrete Pipe to Schedule 1 for a quantity of 330 L.F.
2. Added Pay Item D-752-5.1 Safety End Treatment (12" Dia, 2 Barrel, Type II, TxDOT SETP-PD) to Schedule 1 for a quantity of 2 E.A.
3. Added Pay Item P-153-6.1 Controlled Low-Strength Material (CLSM) to Schedule 1 for a quantity of 18 C.Y.
4. Added Pay Item P-101-5.1 Asphalt Pavement Removal to Schedule 2 for a quantity of 2,787 S.Y.
5. Increased Pay Item P-152-4.3 Embankment In Place for Schedule 1 to 9,574 C.Y.
6. Reduced Pay Item P-207-5.1 In-Place Full Depth Recycled (FDR) Asphalt Aggregate Base Course (8" Depth) for Schedule 1 to 69,745 S.Y.
7. Increased Pay Item P-156-8.1 Cement Treated Subgrade (6") for Schedule 1 to 11,875 S.Y.
8. Increased Pay Item P-209-5.1 Crushed Aggregate Base Course (6") for Schedule 1 to 11,300 S.Y.
9. Decreased Pay Item T-901-5.1 Seeding for Schedule 1 to 20.2 A.C.

**Specification**

1. Updated the "Table of Contents of Technical Specifications" to include D-752 Concrete Culverts, Headwalls, and Miscellaneous Drainage Structures.
2. Updated the "Drawing Index" to include sheets CC-102 and CC-502.
3. Added Specification D-752 Concrete Culverts, Headwalls, and Miscellaneous Drainage Structures.
4. Unstruck section D-701-3.4a for Concrete Pipe.
5. Unstruck section D-701-3.5-1a to include, "If CLSM embedment material is used, it shall conform to the plan details."
6. Updated D-701-5.0 to include Pay Item D-701-5.2 for 12" Reinforced Concrete Pipe per linear foot.

**Plans**

1. Updated the Sheet List on sheet GI-002 to include added sheets CC-102 and CC-502.
2. Updated GI-101 to include the additional New Construction pavement limits on Taxiway A and updated the earthwork table quantity for Schedule 1.
3. Updated sheet GI-201 to include the Taxiway A drainage pipe baseline "Storm Line A".
4. Updated the "Number" column for the Taxiway G Baselines on sheet GI-202.
5. Updated the asphalt pavement removal and full depth reclamation areas on Taxiway A on sheet CD-102.
6. Updated Typical Section 4 on sheet CP-002 to reflect the updated New Construction pavement limits on Taxiway A from Sta 207+00.00 to Sta 218+52.00
7. Updated callout on Detail 1 on sheet CP-005 for the fill material to be subsidiary to P-152.
8. Updated sheet CP-202 to include the adjustments to the profile and New Construction pavement limits on Taxiway A from Sta 207+00.00 to Sta 218+52.00
9. Updated sheet CP-203 to include the adjustments to the profile and New Construction pavement limits on Taxiway A from Sta 207+00.00 to Sta 218+52.00
10. Added sheet CC-102, Storm Drain Plan & Profile 2
11. Added Detail 4 for Concrete Pipe Encasement to sheet CC-501.
12. Added sheet CC-502, Storm Details 2
13. Updated sheet XS-202 to reflect the updated New Construction pavement limits on Taxiway A at cross section Sta 207+00.00.
14. Updated sheet XS-203 to reflect the updated New Construction pavement limits on Taxiway A from cross sections Sta 208+00.00 to Sta 210+00.00.
15. Updated sheet XS-204 to reflect the updated New Construction pavement limits on Taxiway A from cross sections Sta 211+00.00 to Sta 213+00.00.

By:  \_\_\_\_\_

Alex Jessop, P.E.  
Project Engineer

June 6, 2023  
Addendum No.1

**Attachments:**

1. Bid Form
2. Table of Contents of Technical Specifications
3. Drawing Index
4. D-752 Concrete Culverts, Headwalls, and Miscellaneous Drainage Structures
5. D-701 Pipe for Storm Drains and Culverts
6. GI-002 – Sheet Index
7. GI-101 – Project Layout Plan
8. GI-201 – Survey Control Plan 1
9. GI-202 – Survey Control Plan 2
10. CD-102 – Runway 16-34 and Taxiway A Demolition Plan 2
11. CP-002 – Typical Sections 2
12. CP-005 – Miscellaneous Details
13. CP-202 – Taxiway A Plan and Profile 2
14. CP-203 – Taxiway A Plan and Profile 3
15. CC-102 – Storm Drain Plan & Profile 2
16. CC-501 – Storm Details 1
17. CC-502 – Storm Details 2
18. XS-202 – Taxiway A Cross Sections 2
19. XS-203 – Taxiway A Cross Sections 3
20. XS-204 – Taxiway A Cross Sections 4



**RUNWAY 16-34 AND TAXIWAY A RECONSTRUCTION**

**00 01 10 TABLE OF CONTENTS**

**CONTRACT DOCUMENTS AND GENERAL REQUIREMENTS**

**SUPPLEMENTAL SPECIFICATIONS**

SS-101	SAFETY PLAN COMPLIANCE DOCUMENT (SPCD)
SS-120	CONSTRUCTION SAFETY AND SECURITY
SS-300	BASIC ELECTRICAL REQUIREMENTS
SS-301	ELECTRICAL DEMOLITION AND RELOCATION WORK
SS-310	AIRPORT LIGHTING SYSTEMS

**TECHNICAL SPECIFICATIONS**

C-100	CONTRACTOR QUALITY CONTROL PROGRAM (CQCP)
C-102	TEMPORARY AIR AND WATER POLLUTION, SOIL EROSION, AND SILTATION CONTROL
C-105	MOBILIZATION
C-110	METHOD OF ESTIMATING PERCENTAGE OF MATERIAL WITHIN SPECIFICATION LIMITS (PWL)
P-101	PREPARATION/REMOVAL OF EXISTING PAVEMENTS
P-151	CLEARING AND GRUBBING
P-152	EXCAVATION, SUBGRADE, AND EMBANKMENT
P-153	CONTROLLED LOW-STRENGTH MATERIAL (CLSM)
P-156	CEMENT TREATED SUBGRADE
P-207	IN-PLACE FULL DEPTH RECLAMATION (FDR) RECYCLED ASPHALT AGGREGATE BASE COURSE
P-209	CRUSHED AGGREGATE BASE COURSE
P-401	ASPHALT MIX PAVEMENT
P-602	EMULSIFIED ASPHALT PRIME COAT
P-603	EMULSIFIED ASPHALT TACK COAT
P-610	CONCRETE FOR MISCELLANEOUS STRUCTURES
P-620	RUNWAY AND TAXIWAY MARKING
T-901	SEEDING
T-905	TOPSOIL
D-701	PIPE FOR STORM DRAINS AND CULVERTS
D-752	CONCRETE CULVERTS, HEADWALLS, AND MISCELLANEOUS DRAINAGE STRUCTURES
L-108	UNDERGROUND POWER CABLE FOR AIRPORTS
L-110	AIRPORT UNDERGROUND ELECTRICAL DUCT BANKS AND CONDUITS
L-115	ELECTRICAL MANHOLES AND JUNCTION STRUCTURES
L-125	INSTALLATION OF AIRPORT LIGHTING SYSTEMS
DI	DRAWING INDEX



DRAWING INDEX  
ANDREW'S COUNTY AIRPORT  
TxDOT CSJ No. 2306ANDRW  
RUNWAY 16-34 AND TAXIWAY A RECONSTRUCTION

**GENERAL**

GI-001	COVER SHEET
GI-002	SHEET INDEX
GI-101	PROJECT LAYOUT PLAN
GI-201	SURVEY CONTROL PLAN 1
GI-202	SURVEY CONTROL PLAN 2
GC-001	CONSTRUCTION SAFETY AND PHASING NOTES 1
GC-002	CONSTRUCTION SAFETY AND PHASING NOTES 2
GC-003	CONSTRUCTION SAFETY AND PHASING PLAN - OVERVIEW
GC-101	CSPP - PHASE 1
GC-201	CSPP - PHASE 2
GC-301	CSPP - PHASE 3
GC-401	CSPP - PHASE 4
GC-601	CONSTRUCTION SAFETY DETAILS

**CIVIL**

CE-001	EROSION CONTROL NOTES
CE-101	EROSION CONTROL PLAN
CE-201	EROSION CONTROL DETAILS
CD-101	RUNWAY 16-34 AND TAXIWAY A DEMOLITION PLAN 1
CD-102	RUNWAY 16-34 AND TAXIWAY A DEMOLITION PLAN 2
CD-103	RUNWAY 16-34 AND TAXIWAY A DEMOLITION PLAN 3
CD-104	RUNWAY 16-34 AND TAXIWAY A DEMOLITION PLAN 4
CD-201	TAXIWAY G DEMOLITION PLAN
CD-301	RUNWAY 2-20 AND TAXIWAY D DEMOLITION PLAN 1
CD-302	RUNWAY 2-20 AND TAXIWAY D DEMOLITION PLAN 2
CP-001	TYPICAL SECTIONS 1
CP-002	TYPICAL SECTIONS 2
CP-003	TYPICAL SECTIONS 3
CP-004	TYPICAL SECTIONS 4
CP-005	MISCELLANEOUS DETAILS
CP-101	RUNWAY 16-34 PLAN AND PROFILE 1
CP-102	RUNWAY 16-34 PLAN AND PROFILE 2
CP-103	RUNWAY 16-34 PLAN AND PROFILE 3
CP-104	RUNWAY 16-34 PLAN AND PROFILE 4
CP-105	RUNWAY 16-34 PLAN AND PROFILE 5
CP-106	RUNWAY 16-34 PLAN AND PROFILE 6
CP-107	RUNWAY 16-34 PLAN AND PROFILE 7
CP-108	RUNWAY 16-34 PLAN AND PROFILE 8
CP-109	RUNWAY 16-34 PLAN AND PROFILE 9
CP-110	RUNWAY 16-34 PLAN AND PROFILE 10
CP-111	RUNWAY 16-34 PLAN AND PROFILE 11

CP-112	RUNWAY 16-34 PLAN AND PROFILE 12
CP-113	RUNWAY 16-34 PLAN AND PROFILE 13
CP-114	RUNWAY 16-34 PLAN AND PROFILE 14
CP-115	RUNWAY 16-34 PLAN AND PROFILE 15
CP-116	RUNWAY 16-34 PLAN AND PROFILE 16
CP-201	TAXIWAY A PLAN AND PROFILE 1
CP-202	TAXIWAY A PLAN AND PROFILE 2
CP-203	TAXIWAY A PLAN AND PROFILE 3
CP-204	TAXIWAY A PLAN AND PROFILE 4
CP-205	TAXIWAY A PLAN AND PROFILE 5
CP-206	TAXIWAY A PLAN AND PROFILE 6
CP-207	TAXIWAY A PLAN AND PROFILE 7
CP-208	TAXIWAY A PLAN AND PROFILE 8
CP-209	TAXIWAY A PLAN AND PROFILE 9
CP-210	TAXIWAY A PLAN AND PROFILE 10
CP-211	TAXIWAY A PLAN AND PROFILE 11
CP-212	TAXIWAY A PLAN AND PROFILE 12
CP-301	TAXIWAY G PLAN AND PROFILE 1
CP-302	TAXIWAY G PLAN AND PROFILE 2
CP-401	TAXIWAY D PLAN AND PROFILE 1
CP-402	TAXIWAY D PLAN AND PROFILE 2
CP-501	RUNWAY 2-20 PLAN AND PROFILE 1
CP-502	RUNWAY 2-20 PLAN AND PROFILE 2
CP-601	TAXIWAY H PLAN AND PROFILE
CP-701	TAXIWAY C PLAN AND PROFILE
CP-801	TAXIWAY B PLAN AND PROFILE
CP-901	TAXIWAY D PLAN AND PROFILE 1 (ADDITIVE ALTERNATE 1)
CP-902	TAXIWAY D PLAN AND PROFILE 2 (ADDITIVE ALTERNATE 1)
CP-903	TAXIWAY D PLAN AND PROFILE 3 (ADDITIVE ALTERNATE 1)
CG-101	GRADING PLAN 1
CG-102	GRADING PLAN 2
CC-101	STORM DRAIN PLAN & PROFILE 1
CC-102	STORM DRAIN PLAN & PROFILE 2
CC-501	STORM DETAILS 1
CC-502	STORM DETAILS 2
CM-101	RUNWAY 16-34 PAVEMENT MARKING PLAN 1
CM-102	RUNWAY 16-34 PAVEMENT MARKING PLAN 2
CM-103	RUNWAY 16-34 PAVEMENT MARKING PLAN 3
CM-104	RUNWAY 16-34 PAVEMENT MARKING PLAN 4
CM-105	RUNWAY 16-34 PAVEMENT MARKING PLAN 5
CM-106	RUNWAY 16-34 PAVEMENT MARKING PLAN 6
CM-107	RUNWAY 16-34 PAVEMENT MARKING PLAN 7
CM-201	TAXIWAY A PAVEMENT MARKING PLAN 1
CM-202	TAXIWAY A PAVEMENT MARKING PLAN 2
CM-203	TAXIWAY A PAVEMENT MARKING PLAN 3
CM-204	TAXIWAY A PAVEMENT MARKING PLAN 4
CM-205	TAXIWAY A PAVEMENT MARKING PLAN 5

CM-206	TAXIWAY A PAVEMENT MARKING PLAN 6
CM-207	CONNECTOR TAXIWAY A PAVEMENT MARKING PLAN 7
CM-301	TAXIWAY G PAVEMENT MARKING PLAN
CM-401	TAXIWAY D PAVEMENT MARKING PLAN
CM-402	TAXIWAY D PAVEMENT MARKING PLAN 1 (ADDITIVE ALTERNATE 1)
CM-403	TAXIWAY D PAVEMENT MARKING PLAN 2 (ADDITIVE ALTERNATE 1)
CM-501	RUNWAY 2-20 PAVEMENT MARKING PLAN
CM-601	TAXIWAYS C & H PAVEMENT MARKING PLAN
CM-701	TAXIWAY B PAVEMENT MARKING PLAN
CM-901	PAVEMENT MARKING DETAILS 1
CM-902	PAVEMENT MARKING DETAILS 2

## **ELECTRICAL**

EN-001	LIGHTING LEGEND & GENERAL NOTES
ED-101	RUNWAY 16-34 AND TAXIWAY A LIGHTING REMOVAL PLAN 1
ED-102	RUNWAY 16-34 AND TAXIWAY A LIGHTING REMOVAL PLAN 2
ED-103	RUNWAY 16-34 AND TAXIWAY A LIGHTING REMOVAL PLAN 3
ED-104	RUNWAY 16-34 AND TAXIWAY A LIGHTING REMOVAL PLAN 4
ED-201	LIGHTING REMOVAL DETAILS
EL-101	RUNWAY 16-34 AND TAXIWAY A LIGHTING INSTALLATION PLAN 1
EL-102	RUNWAY 16-34 AND TAXIWAY A LIGHTING INSTALLATION PLAN 2
EL-103	RUNWAY 16-34 AND TAXIWAY A LIGHTING INSTALLATION PLAN 3
EL-104	RUNWAY 16-34 AND TAXIWAY A LIGHTING INSTALLATION PLAN 4
EL-201	LIGHTING INSTALLATION DETAILS 1
EL-202	LIGHTING INSTALLATION DETAILS 2
EL-203	LIGHTING INSTALLATION DETAILS 3
EL-204	LIGHTING INSTALLATION DETAILS 4
EL-205	LIGHTING INSTALLATION DETAILS 5
EL-206	LIGHTING INSTALLATION DETAILS 6
EL-207	LIGHTING INSTALLATION DETAILS 7
EL-208	LIGHTING INSTALLATION DETAILS 8
EL-209	LIGHTING INSTALLATION DETAILS 9

## **CROSS SECTIONS**

XS-101	RUNWAY 16-34 CROSS SECTIONS 1
XS-102	RUNWAY 16-34 CROSS SECTIONS 2
XS-103	RUNWAY 16-34 CROSS SECTIONS 3
XS-104	RUNWAY 16-34 CROSS SECTIONS 4
XS-105	RUNWAY 16-34 CROSS SECTIONS 5
XS-106	RUNWAY 16-34 CROSS SECTIONS 6
XS-107	RUNWAY 16-34 CROSS SECTIONS 7
XS-108	RUNWAY 16-34 CROSS SECTIONS 8
XS-109	RUNWAY 16-34 CROSS SECTIONS 9
XS-110	RUNWAY 16-34 CROSS SECTIONS 10
XS-111	RUNWAY 16-34 CROSS SECTIONS 11
XS-112	RUNWAY 16-34 CROSS SECTIONS 12
XS-113	RUNWAY 16-34 CROSS SECTIONS 13

XS-505	RUNWAY 2-20 CROSS SECTIONS 5
XS-506	RUNWAY 2-20 CROSS SECTIONS 6
XS-601	TAXIWAY H CROSS SECTIONS 1
XS-602	TAXIWAY H CROSS SECTIONS 2
XS-701	TAXIWAY C CROSS SECTIONS 1
XS-702	TAXIWAY C CROSS SECTIONS 2
XS-801	TAXIWAY B CROSS SECTIONS 1
XS-802	TAXIWAY B CROSS SECTIONS 2
XS-901	TAXIWAY D (ADDITIVE ALTERNATE 1) CROSS SECTIONS 4
XS-902	TAXIWAY D (ADDITIVE ALTERNATE 1) CROSS SECTIONS 5
XS-903	TAXIWAY D (ADDITIVE ALTERNATE 1) CROSS SECTIONS 6
XS-904	TAXIWAY D (ADDITIVE ALTERNATE 1) CROSS SECTIONS 7
XS-905	TAXIWAY D (ADDITIVE ALTERNATE 1) CROSS SECTIONS 8
XS-906	TAXIWAY D (ADDITIVE ALTERNATE 1) CROSS SECTIONS 9
XS-907	TAXIWAY D (ADDITIVE ALTERNATE 1) CROSS SECTIONS 10
XS-908	TAXIWAY D (ADDITIVE ALTERNATE 1) CROSS SECTIONS 11
XS-909	TAXIWAY D (ADDITIVE ALTERNATE 1) CROSS SECTIONS 12

**ITEM D-752 CONCRETE CULVERTS, HEADWALLS, AND MISCELLANEOUS DRAINAGE  
STRUCTURES**

**DESCRIPTION**

**752-1.1** This item shall consist of plain ~~[reinforced]~~ concrete culverts, headwalls, and miscellaneous drainage **Safety End Treatment** structures constructed in accordance with these specifications, at the specified locations and conforming to the lines, grades, and dimensions shown on the plans or required by the RPR.

**MATERIALS**

**752-2.1 Concrete.** Plain concrete shall meet the requirements of Item P-610.

**CONSTRUCTION METHODS**

**752-3.1 Unclassified excavation.**

a. Trenches and foundation pits for structures or structure footings shall be excavated to the lines and grades and elevations shown on the plans. The excavation shall be of sufficient size to permit the placing of the full width and length of the structure or structure footings shown. The elevations of the bottoms of footings, as shown on the plans, shall be considered as approximate only; and the RPR may approve, in writing, changes in dimensions or elevations of footings necessary to secure a satisfactory foundation.

b. Boulders, logs, or any other objectionable material encountered in excavation shall be removed. All rock or other hard foundation material shall be cleaned of all loose material and cut to a firm surface either level, stepped, or serrated, as directed by the RPR. All seams or crevices shall be cleaned out and grouted. All loose and disintegrated rock and thin strata shall be removed. When concrete will rest on a surface other than rock, the bottom of the excavation shall not be disturbed and excavation to final grade shall not be made until immediately before the concrete or reinforcing steel is placed.

c. The Contractor shall do all bracing, sheathing, or shoring necessary to perform and protect the excavation and the structure as required for safety or conformance to governing laws. The cost of bracing, sheathing, or shoring shall be included in the unit price bid for excavation.

d. All bracing, sheathing, or shoring shall be removed by the Contractor after the completion of the structure. Removal shall not disturb or damage the finished concrete. The cost of removal shall be included in the unit price bid for excavation.

e. After each excavation is completed, the Contractor shall notify the RPR. No concrete or reinforcing steel shall be placed until the RPR has approved the depth of the excavation and the character of the foundation material.

**752-3.2 Backfilling.**

a. After a structure has been completed, backfilling with approved material shall be accomplished by applying the fill in horizontal layers not to exceed 8 inches in loose depth, and compacted. The field density of the compacted material shall be at least 90% of the maximum density for cohesive soils and 95% of the maximum density for noncohesive soils. The maximum density shall be determined in accordance with ASTM D698. The field density shall be determined in accordance with ASTM D1556.

The in-place field density shall be determined in accordance with ASTM D1556

b. No backfilling shall be placed against any structure until approved by the RPR. For concrete, approval shall not be given until the concrete has been in place seven (7) days, or until tests establish that the concrete has attained sufficient strength to withstand any pressure created by the backfill or the placement methods.

c. Fill placed around concrete culverts shall be deposited on each side at the same time and to approximately the same elevation. All slopes bounding or within the areas to be backfilled shall be stepped or serrated to prevent wedge action against the structure.

d. Backfill will not be measured for direct payment. Performance of this work shall be considered as a subsidiary obligation of the Contractor, covered under the *item which it is contained*. ~~contract unit price for "unclassified excavation for structures."~~

**752-3.3 Weep holes.** Weep holes shall be constructed as shown on the plans.

**752-3.4 Cleaning and restoration of site.** After the backfill is completed, the Contractor shall dispose of all surplus material, dirt, and rubbish from the site. Surplus dirt may be deposited in embankment, shoulders, or as approved by the RPR. The Contractor shall restore all disturbed areas to their original condition. The Contractor shall remove all tools and equipment, leaving the entire site free, clear, and in good condition.

### METHOD OF MEASUREMENT

~~**752-4.1** The quantity of unclassified excavation for structures shall be the number of cubic yards measured in original position, of material excavated in accordance with the plans, or as approved by the RPR; but in no case shall any yardage be included in the measurement for payment which is outside of a volume bounded by vertical planes 18 inches outside of and parallel to the neat lines of the footings.~~

~~**752-4.2** Concrete shall be measured by the number of cubic yards of concrete, complete in place and accepted. In computing the yardage of concrete for payment, the dimensions used shall be those shown on the plans or approved by the RPR. No measurements or other allowances shall be made for forms, false work, cofferdams, pumping, bracing, expansion joints, or finishing of the concrete. No deductions in yardage shall be made for the volumes of reinforcing steel or embedded items.~~

~~**752-4.3** The quantity of reinforcing steel shall be the calculated theoretical number of pounds placed as shown on the plans, complete in place and accepted. The unit weight used for deformed bars shall be the weight of plain square or round bars, as the case may be, of equal nominal size.~~

~~**752-4.1** Concrete culverts, headwalls, and miscellaneous drainage~~ **safety end treatment** ~~structures shall be measured by the unit, completed in place and accepted.~~

~~**752-4.2** Reinforcing steel shall not be measured for separate payment but shall be considered subsidiary to the structure in which it is contained.~~

### BASIS OF PAYMENT

~~**752-5.1** Payment will be made at the contract unit price per cubic yard for unclassified excavation for structures.~~

~~**752-5.2** Payment will be made at the contract unit price per cubic yard for concrete for the structures.~~

~~**752-5.3** Payment will be made at the contract unit price per pound for reinforcing steel.~~

~~**752-5.1** Payment will be made at the contract unit price per each for concrete culverts, headwalls, and miscellaneous drainage~~ **safety end treatment** ~~structures. These prices shall be full compensation for furnishing all materials and for all preparation, excavation, and placing the materials, furnishing and installation of such specials and connections to pipes and other structures as may be required to complete the item as shown on the plan; and for all labor, equipment, tools, and incidentals necessary to complete the structure.~~

Payment will be made under:

Item D-752 5.1                      Safety End Treatment (12" Dia, Type II, TxDOT SETP-PD) — per Each

### REFERENCES

The publications listed below form a part of this specification to the extent referenced. The publications are referred to within the text by the basic designation only.

ASTM International (ASTM)

ASTM D698	Standard Test Methods for Laboratory Compaction Characteristics of Soil Using Standard Effort (12,400 ft-lb/ft <sup>3</sup> (600 kN-m/m <sup>3</sup> ))
ASTM D1556	Standard Test Method for Density and Unit Weight of Soil in Place by the Sand-Cone Method

**END OF ITEM D-752**



**PAGE INTENTIONALLY LEFT BLANK**

## ITEM D-701 PIPE FOR STORM DRAINS AND CULVERTS

### DESCRIPTION

**701-1.1** This item shall consist of the construction of pipe culverts and storm drains in accordance with these specifications and in reasonably close conformity with the lines and grades shown on the plans.

### MATERIALS

**701-2.1** Materials shall meet the requirements shown on the plans and specified below. Underground piping and components used in drainage systems for terminal and aircraft fueling ramp drainage shall be noncombustible and inert to fuel in accordance with National Fire Protection Association (NFPA) 415.

**701-2.2 Pipe.** The pipe shall be of the type called for on the plans or in the proposal and shall be in accordance with the following appropriate requirements:

ASTM F667 Standard Specification for 3 through 24 in Corrugated Polyethylene Pipe and Fittings

ASTM F714 Standard Specification for Polyethylene (PE) Plastic Pipe (DR-PR) Based on Outside Diameter

ASTM F2736 Standard Specification for 6 to 30 in. (152 to 762 mm) Polypropylene (PP) Corrugated Single Wall Pipe and Double Wall Pipe

**701-2.3 Concrete.** Not Used.

**701-2.4 Rubber gaskets.** Rubber gaskets for rigid pipe shall conform to the requirements of ASTM C443. Rubber gaskets for PVC pipe, polyethylene, and polypropylene pipe shall conform to the requirements of ASTM F477. Rubber gaskets for zinc-coated steel pipe and precoated galvanized pipe shall conform to the requirements of ASTM D1056, for the "RE" closed cell grades. Rubber gaskets for steel reinforced thermoplastic ribbed pipe shall conform to the requirements of ASTM F477.

**701-2.5 Joint mortar.** Not used.

**701-2.6 Joint fillers.** Not used.

**701-2.7 Plastic gaskets.** Not used.

**701-2.8. Controlled low-strength material (CLSM).** Controlled low-strength material shall conform to the requirements of Item P-153. ~~When CLSM is used, all joints shall have gaskets.~~

**701-2.9 Precast box culverts.** Manufactured in accordance with and conforming to ASTM C1433.

**701-2.10 Precast concrete pipe.** Precast concrete structures shall be furnished by a plant meeting National Precast Concrete Association Plant Certification Program or American Concrete Pipe Association QCast Plant Certification program.

### CONSTRUCTION METHODS

**701-3.1 Excavation.** The width of the pipe trench shall be sufficient to permit satisfactory jointing of the pipe and thorough tamping of the bedding material under and around the pipe, but it shall not be less than the external diameter of the pipe plus 12 inches on each side. The trench walls shall be approximately vertical.

The Contractor shall comply with all current federal, state and local rules and regulations governing the safety of men and materials during the excavation, installation and backfilling operations. Specifically, the Contractor shall observe that all requirements of the Occupational Safety and Health Administration (OSHA) relating to excavations, trenching and shoring are strictly adhered to. The width of the trench shall be sufficient to permit satisfactorily jointing of the pipe and thorough compaction of the bedding material under

the pipe and backfill material around the pipe, but it shall not be greater than the widths shown on the plans trench detail.

Where rock, hardpan, or other unyielding material is encountered, the Contractor shall remove it from below the foundation grade for a depth of at least 8 inch or 1/2 inch for each foot of fill over the top of the pipe (whichever is greater) but for no more than three-quarters of the nominal diameter of the pipe. The excavation below grade should be filled with granular material to form a uniform foundation.

Where a firm foundation is not encountered at the grade established, due to soft, spongy, or other unstable soil, the unstable soil shall be removed and replaced with approved granular material for the full trench width. The RPR shall determine the depth of removal necessary. The granular material shall be compacted to provide adequate support for the pipe.

The excavation for pipes placed in embankment fill shall not be made until the embankment has been completed to a height above the top of the pipe as shown on the plans.

**701-3.2 Bedding.** The bedding surface for the pipe shall provide a foundation of uniform density to support the pipe throughout its entire length.

~~a. Rigid pipe. The pipe bedding shall be constructed uniformly for the full length of the pipe barrel, as required on the plans. The maximum aggregate size shall be 1 inch when the bedding thickness is less than 6 inches, and 1 1/2 inches when the bedding thickness is greater than 6 inches. Bedding shall be number 57 stone as defined in ASTM C 33 or approved equal, loosely placed uncompacted material under the middle third of the pipe prior to placement of the pipe.~~

**b. Flexible pipe.** For flexible pipe, the bed shall be roughly shaped to fit the pipe, and a bedding blanket of sand or fine granular material shall be provided as follows:

**Flexible Pipe Bedding**

Pipe Corrugation Depth		Minimum Bedding Depth	
inch	mm	inch	mm
1/2	12	4	25
1	25	2	50
2	50	3	75
2-1/2	60	3-1/2	90

**c. Other pipe materials.** For PVC, polyethylene, polypropylene, or fiberglass pipe, the bedding material shall consist of coarse sands and gravels with a maximum particle size of 3/4 inches. For pipes installed under paved areas, no more than 12% of the material shall pass the No. 200 (0.075 mm) sieve. For all other areas, no more than 50% of the material shall pass the No. 200 (0.075 mm) sieve. The bedding shall have a thickness of at least 6 inches below the bottom of the pipe and extend up around the pipe for a depth of not less than 50% of the pipe's vertical outside diameter.

**701-3.3 Laying pipe.** The pipe laying shall begin at the lowest point of the trench and proceed up grade. The lower segment of the pipe shall be in contact with the bedding throughout its full length. Bell or groove ends of rigid pipes and outside circumferential laps of flexible pipes shall be placed facing up grade.

Paved or partially lined pipe shall be placed so that the longitudinal center line of the paved segment coincides with the flow line.

Elliptical and elliptically reinforced concrete pipes shall be placed with the manufacturer's reference lines designating the top of the pipe within five degrees of a vertical plane through the longitudinal axis of the pipe.

**701-3.4 Joining pipe.** Joints shall be made with ~~(1) cement mortar, (2) cement grout, (3) rubber gaskets, (4) plastic gaskets, (5) coupling bands.~~

~~Mortar joints shall be made with an excess of mortar to form a continuous bead around the outside of the pipe and shall be finished smooth on the inside. Molds or runners shall be used for grouted joints to retain the poured grout. Rubber ring gaskets shall be installed to form a flexible watertight seal.~~

**a. Concrete pipe.** *Concrete pipe may be either bell and spigot or tongue and groove. Pipe sections at joints shall be fully seated and the inner surfaces flush and even. Concrete pipe joints shall be sealed with rubber gaskets meeting ASTM C443 when leak resistant joints are required.*

**b. Metal pipe.** ~~Metal pipe shall be firmly joined by form-fitting bands conforming to the requirements of ASTM A760 for steel pipe and AASHTO M196 for aluminum pipe.~~

**c. PVC, Polyethylene, or Polypropylene pipe.** Joints for PVC, Polyethylene, or Polypropylene pipe shall conform to the requirements of ASTM D3212 when leak resistant joints are required. Joints for PVC and Polyethylene pipe shall conform to the requirements of AASHTO M304 when soil tight joints are required. Fittings for polyethylene pipe shall conform to the requirements of AASHTO M252 or ASTM M294. Fittings for polypropylene pipe shall conform to ASTM F2881, ASTM F2736, or ASTM F2764.

**d. Fiberglass pipe.** ~~Joints and fittings shall be as detailed on the plans and in accordance with the manufacturers recommendations. Joints shall meet the requirements of ASTM D4161 for flexible elastomeric seals.~~

**701-3.5 Embedment and Overfill.** Pipes shall be inspected before any fill material is placed; any pipes found to be out of alignment, unduly settled, or damaged shall be removed and re-laid or replaced at the Contractor's expense.

#### **701-3.5-1 Embedment Material Requirements**

**a. Concrete Pipe.** ~~Embedment material and compaction requirements shall be in accordance with the applicable Type of Standard Installation (Types 1, 2, 3, or 4) per ASTM C1479. *If a concrete cradle or CLSM embedment material is used, it shall conform to the plan details.*~~

**b. Plastic and fiberglass Pipe.** ~~Embedment material shall meet the requirements of ASTM D3282, A-1, A-2-4, A-2-5, or A-3. Embedment material shall be free of organic material, stones larger than 1.5 inches in the greatest dimension, or frozen lumps. Embedment material shall extend to 12 inches above the top of the pipe as shown in the plans.~~

**c. Metal Pipe.** ~~Embedment material shall be granular as specified in the contract document and specifications, and shall be free of organic material, rock fragments larger than 1.5 inches in the greatest dimension and frozen lumps. As a minimum, backfill materials shall meet the requirements of ASTM D3282, A-1, A-2, or A-3. Embedment material shall extend to 12 inches above the top of the pipe.~~

**701-3.5-2 Placement of Embedment Material.** ~~The embedment material shall be compacted in layers not exceeding 6 inches on each side of the pipe and shall be brought up one foot above the top of the pipe or to natural ground level, whichever is greater. Thoroughly compact the embedment material under the haunches of the pipe without displacing the pipe. Material shall be brought up evenly on each side of the pipe for the full length of the pipe.~~

~~When the top of the pipe is above the top of the trench, the embedment material shall be compacted in layers not exceeding 6 inches and shall be brought up evenly on each side of the pipe to one foot above the top of the pipe. All embedment material shall be compacted to a density required under Item P-152.~~

Concrete cradles and flowable fills, such as controlled low strength material (CLSM) or controlled density fill (CDF), may be used for embedment provided adequate flotation resistance can be achieved by restraints, weighing, or placement technique.

It shall be the Contractor's responsibility to protect installed pipes and culverts from damage due to construction equipment operations. The Contractor shall be responsible for installation of any extra strutting or backfill required to protect pipes from the construction equipment.

**701-3.6 Overfill.** Pipes shall be inspected before any overfill is in place. Any pipes found to be out of alignment, unduly settled, or damaged shall be removed and relaid or replaced at the Contractor's expense. Evaluation of any damage to RCP shall be evaluated based on AASHTO R73.

Overfill material shall be placed and compacted in layers as required to achieve compaction to at least 95 percent standard proctor per ASTM D698. The soil shall contain no debris, organic matter, frozen material, or stones with a diameter greater than one half the thickness of the compacted layers being placed.

### **701-3.7 Inspection Requirements**

An initial post installation inspection shall be performed by the RPR no sooner than 30 days after completion of installation and final backfill. Clean or flush all lines prior to inspection.

Determine whether the allowable deflection has been exceeded by use of a laser profiler for internal pipe diameters of 48 inches or less, or direct measurement for internal pipe diameters greater than 48 inches. Laser profile equipment shall utilize low barrel distortion video equipment. Deflection of installed pipe shall not exceed the limits provided in the table below, as a percentage of the average inside diameter of the pipe.

Maximum Allowable Pipe Deflection

Type of Pipe	Maximum Allowable Deflection (%)
Corrugated Metal Pipe	5
Concrete Lined CMP	3
Thermoplastic Pipe	5
Fiberglass	5

If deflection readings in excess of the allowable deflection are obtained, remove the pipe with excessive deflection and replace with new pipe. Isolated areas may exceed allowable by 2.5% with concurrence of RPR. Repair or replace any pipe with cracks exhibiting displacement across the crack, bulges, creases, tears, spalls, or delaminations. The report for flexible pipe shall include as a minimum, the deflection results and final post installation inspection report. The inspection report shall include: a copy of all video taken, pipe location identification, equipment used for inspection, inspector name, deviation from design line and grade, and inspector's notes.

### **METHOD OF MEASUREMENT**

**701-4.1** The length of pipe shall be measured in linear feet of pipe in place, completed, and accepted. It shall be measured along the centerline of the pipe from end or inside face of structure to the end or inside face of structure, whichever is applicable. All fittings shall be included in the footage as typical pipe sections in the pipe being measured.

**701-4.2** *The volume of CLSM bedding will be measured for separate payment under item P-153.*

### **BASIS OF PAYMENT**

**701-5.0** These prices shall fully compensate the Contractor for furnishing all materials and for all preparation, excavation, and installation of these materials; and for all labor, equipment, tools, and incidentals necessary to complete the item.

**701-5.1** Payment will be made at the contract unit price per linear foot for 6" High Density Polyethylene (HDPE) Pipe.

**701-5.2** *Payment will be made at the contract unit price per linear foot for 12" Reinforced Concrete Pipe.*

Payment will be made under:

Item D-701-5.1	6" High Density Polyethylene (HDPE) Pipe - per linear foot
<b>Item D-701-5.2</b>	<b>12" Reinforced Concrete Pipe – per linear foot</b>

#### **REFERENCES**

The publications listed below form a part of this specification to the extent referenced. The publications are referred to within the text by the basic designation only.

American Association of State Highway and Transportation Officials (AASHTO)

AASHTO M167	Standard Specification for Corrugated Steel Structural Plate, Zinc-Coated, for Field-Bolted Pipe, Pipe-Arches, and Arches
AASHTO M190	Standard Specification for Bituminous-Coated Corrugated Metal Culvert Pipe and Pipe Arches
AASHTO M196	Standard Specification for Corrugated Aluminum Pipe for Sewers and Drains
AASHTO M219	Standard Specification for Corrugated Aluminum Alloy Structural Plate for Field-Bolted Pipe, Pipe-Arches, and Arches
AASHTO M243	Standard Specification for Field Applied Coating of Corrugated Metal Structural Plate for Pipe, Pipe-Arches, and Arches
AASHTO M252	Standard Specification for Corrugated Polyethylene Drainage Pipe
AASHTO M294	Standard Specification for Corrugated Polyethylene Pipe, 300- to 1500-mm (12- to 60-in.) Diameter
AASHTO M304	Standard Specification for Poly (Vinyl Chloride) (PVC) Profile Wall Drain Pipe and Fittings Based on Controlled Inside Diameter
AASHTO MP20	Standard Specification for Steel Reinforced Polyethylene (PE) Ribbed Pipe, 300- to 900-mm (12- to 36-in.) Diameter

ASTM International (ASTM)

ASTM A760	Standard Specification for Corrugated Steel Pipe, Metallic Coated for Sewers and Drains
ASTM A761	Standard Specification for Corrugated Steel Structural Plate, Zinc Coated, for Field-Bolted Pipe, Pipe-Arches, and Arches
ASTM A762	Standard Specification for Corrugated Steel Pipe, Polymer Precoated for Sewers and Drains
ASTM A849	Standard Specification for Post-Applied Coatings, Pavings, and Linings for Corrugated Steel Sewer and Drainage Pipe
ASTM B745	Standard Specification for Corrugated Aluminum Pipe for Sewers and Drains

ASTM C14	Standard Specification for Nonreinforced Concrete Sewer, Storm Drain, and Culvert Pipe
ASTM C76	Standard Specification for Reinforced Concrete Culvert, Storm Drain, and Sewer Pipe
ASTM C94	Standard Specification for Ready Mixed Concrete
ASTM C144	Standard Specification for Aggregate for Masonry Mortar
ASTM C150	Standard Specification for Portland Cement
ASTM C443	Standard Specification for Joints for Concrete Pipe and Manholes, Using Rubber Gaskets
ASTM C506	Standard Specification for Reinforced Concrete Arch Culvert, Storm Drain, and Sewer Pipe
ASTM C507	Standard Specification for Reinforced Concrete Elliptical Culvert, Storm Drain and Sewer Pipe
ASTM C655	Standard Specification for Reinforced Concrete D-Load Culvert, Storm Drain and Sewer Pipe
ASTM C990	Standard Specification for Joints for Concrete Pipe, Manholes, and Precast Box Sections Using Preformed Flexible Joint Sealants
ASTM C1433	Standard Specification for Precast Reinforced Concrete Monolithic Box Sections for Culverts, Storm Drains, and Sewers
ASTM D1056	Standard Specification for Flexible Cellular Materials Sponge or Expanded Rubber
ASTM D3034	Standard Specification for Type PSM Poly (Vinyl Chloride) (PVC) Sewer Pipe and Fittings
ASTM D3212	Standard Specification for Joints for Drain and Sewer Plastic Pipes Using Flexible Elastomeric Seals
ASTM D3262	Standard Specification for "Fiberglass" (Glass-Fiber Reinforced Thermosetting Resin) Sewer Pipe
ASTM D3282	Standard Practice for Classification of Soils and Soil-Aggregate Mixtures for Highway Construction Purposes
ASTM D4161	Standard Specification for "Fiberglass" (Glass-Fiber Reinforced Thermosetting Resin) Pipe Joints Using Flexible Elastomeric Seals
ASTM D6690	Standard Specification for Joint and Crack Sealants, Hot Applied, for Concrete and Asphalt Pavements
ASTM F477	Standard Specification for Elastomeric Seals (Gaskets) for Joining Plastic Pipe
ASTM F667	Standard Specification for 3 through 24 in. Corrugated Polyethylene Pipe and Fittings
ASTM F714	Standard Specification for Polyethylene (PE) Plastic Pipe (DR PR) Based on Outside Diameter

ASTM F794	Standard Specification for Poly (Vinyl Chloride) (PVC) Profile Gravity Sewer Pipe & Fittings Based on Controlled Inside Diameter
ASTM F894	Standard Specification for Polyethylene (PE) Large Diameter Profile Wall Sewer and Drain Pipe
ASTM F949	Standard Specification for Poly (Vinyl Chloride) (PVC) Corrugated Sewer Pipe with a Smooth Interior and Fittings
ASTM F2435	Standard Specification for Steel Reinforced Polyethylene (PE) Corrugated Pipe
ASTM F2562	Specification for Steel Reinforced Thermoplastic Ribbed Pipe and Fittings for Non-Pressure Drainage and Sewerage
ASTM F2736	Standard Specification for 6 to 30 in. (152 to 762 mm) Polypropylene (PP) Corrugated Single Wall Pipe and Double Wall Pipe
ASTM F2764	Standard Specification for 30 to 60 in. (750 to 1500 mm) Polypropylene (PP) Triple Wall Pipe and Fittings for Non-Pressure Sanitary Sewer Applications
ASTM F2881	Standard Specification for 12 to 60 in. (300 to 1500 mm) Polypropylene (PP) Dual Wall Pipe and Fittings for Non-Pressure Storm Sewer Applications

## National Fire Protection Association (NFPA)

NFPA 415	Standard on Airport Terminal Buildings, Fueling Ramp Drainage, and Loading Walkways
----------	---

**END ITEM D-701**




**PAGE INTENTIONALLY LEFT BLANK**

File: L:\2022\22A11972 - E11 RW 16-34 and TW A ReconDrawings\E11\_RW\_RHB-GI-001.dwg, Last Save: 6/6/2023 9:57 AM, Last saved by: JAHenderson  
Last plotted by: Henderson, James, A Plot Style: AECmono.ctb Plot Scale: 1"=1' Plot Date: 6/6/2023 1:41 PM Plotter used: AutoCAD PDF (General Documentation).pc3

Sheet List Table		
Sheet Number	Drawing Number	Sheet Title
GENERAL		
1	GI-001	COVER SHEET
2	GI-002	SHEET INDEX
3	GI-101	PROJECT LAYOUT PLAN
4	GI-201	SURVEY CONTROL PLAN 1
5	GI-202	SURVEY CONTROL PLAN 2
6	GC-001	CONSTRUCTION SAFETY AND PHASING NOTES 1
7	GC-002	CONSTRUCTION SAFETY AND PHASING NOTES 2
8	GC-003	CONSTRUCTION SAFETY AND PHASING PLAN - OVERVIEW
9	GC-101	CSPP - PHASE 1
10	GC-201	CSPP - PHASE 2
11	GC-301	CSPP - PHASE 3
12	GC-401	CSPP - PHASE 4
13	GC-601	CONSTRUCTION SAFETY DETAILS
CIVIL		
14	CE-001	EROSION CONTROL NOTES
15	CE-101	EROSION CONTROL PLAN
16	CE-201	EROSION CONTROL DETAILS
17	CD-101	RUNWAY 16-34 AND TAXIWAY A DEMOLITION PLAN 1
18	CD-102	RUNWAY 16-34 AND TAXIWAY A DEMOLITION PLAN 2
19	CD-103	RUNWAY 16-34 AND TAXIWAY A DEMOLITION PLAN 3
20	CD-104	RUNWAY 16-34 AND TAXIWAY A DEMOLITION PLAN 4
21	CD-201	TAXIWAY G DEMOLITION PLAN
22	CD-301	RUNWAY 2-20 AND TAXIWAY D DEMOLITION PLAN 1
23	CD-302	RUNWAY 2-20 AND TAXIWAY D DEMOLITION PLAN 2
24	CP-001	TYPICAL SECTIONS 1
25	CP-002	TYPICAL SECTIONS 2
26	CP-003	TYPICAL SECTIONS 3
27	CP-004	TYPICAL SECTIONS 4
28	CP-005	MISCELLANEOUS DETAILS
29	CP-101	RUNWAY 16-34 PLAN AND PROFILE 1
30	CP-102	RUNWAY 16-34 PLAN AND PROFILE 2
31	CP-103	RUNWAY 16-34 PLAN AND PROFILE 3
32	CP-104	RUNWAY 16-34 PLAN AND PROFILE 4
33	CP-105	RUNWAY 16-34 PLAN AND PROFILE 5
34	CP-106	RUNWAY 16-34 PLAN AND PROFILE 6
35	CP-107	RUNWAY 16-34 PLAN AND PROFILE 7
36	CP-108	RUNWAY 16-34 PLAN AND PROFILE 8
37	CP-109	RUNWAY 16-34 PLAN AND PROFILE 9
38	CP-110	RUNWAY 16-34 PLAN AND PROFILE 10
39	CP-111	RUNWAY 16-34 PLAN AND PROFILE 11
40	CP-112	RUNWAY 16-34 PLAN AND PROFILE 12
41	CP-113	RUNWAY 16-34 PLAN AND PROFILE 13
42	CP-114	RUNWAY 16-34 PLAN AND PROFILE 14
43	CP-115	RUNWAY 16-34 PLAN AND PROFILE 15
44	CP-116	RUNWAY 16-34 PLAN AND PROFILE 16
45	CP-201	TAXIWAY A PLAN AND PROFILE 1
46	CP-202	TAXIWAY A PLAN AND PROFILE 2
47	CP-203	TAXIWAY A PLAN AND PROFILE 3
48	CP-204	TAXIWAY A PLAN AND PROFILE 4
49	CP-205	TAXIWAY A PLAN AND PROFILE 5
50	CP-206	TAXIWAY A PLAN AND PROFILE 6
51	CP-207	TAXIWAY A PLAN AND PROFILE 7
52	CP-208	TAXIWAY A PLAN AND PROFILE 8
53	CP-209	TAXIWAY A PLAN AND PROFILE 9
54	CP-210	TAXIWAY A PLAN AND PROFILE 10
55	CP-211	TAXIWAY A PLAN AND PROFILE 11
56	CP-212	TAXIWAY A PLAN AND PROFILE 12
57	CP-301	TAXIWAY G PLAN AND PROFILE 1
58	CP-302	TAXIWAY G PLAN AND PROFILE 2
59	CP-401	TAXIWAY D PLAN AND PROFILE 1
60	CP-402	TAXIWAY D PLAN AND PROFILE 2
61	CP-501	RUNWAY 2-20 PLAN AND PROFILE 1
62	CP-502	RUNWAY 2-20 PLAN AND PROFILE 2
63	CP-601	TAXIWAY H PLAN AND PROFILE
64	CP-701	TAXIWAY C PLAN AND PROFILE
65	CP-801	TAXIWAY B PLAN AND PROFILE
66	CP-901	TAXIWAY D PLAN AND PROFILE 1 (ADDITIVE ALTERNATE 1)
67	CP-902	TAXIWAY D PLAN AND PROFILE 2 (ADDITIVE ALTERNATE 1)
68	CP-903	TAXIWAY D PLAN AND PROFILE 3 (ADDITIVE ALTERNATE 1)
69	CG-101	GRADING PLAN 1
70	CG-102	GRADING PLAN 2
71	CG-101	STORM DRAIN PLAN & PROFILE 1
72	CC-102	STORM DRAIN PLAN & PROFILE 2
73	CC-501	STORM DETAILS


Sheet List Table		
Sheet Number	Drawing Number	Sheet Title
74	CC-502	STORM DETAILS 2
75	CM-101	RUNWAY 16-34 PAVEMENT MARKING PLAN 1
76	CM-102	RUNWAY 16-34 PAVEMENT MARKING PLAN 2
77	CM-103	RUNWAY 16-34 PAVEMENT MARKING PLAN 3
78	CM-104	RUNWAY 16-34 PAVEMENT MARKING PLAN 4
79	CM-105	RUNWAY 16-34 PAVEMENT MARKING PLAN 5
80	CM-106	RUNWAY 16-34 PAVEMENT MARKING PLAN 6
81	CM-107	RUNWAY 16-34 PAVEMENT MARKING PLAN 7
82	CM-201	TAXIWAY A PAVEMENT MARKING PLAN 1
83	CM-202	TAXIWAY A PAVEMENT MARKING PLAN 2
84	CM-203	TAXIWAY A PAVEMENT MARKING PLAN 3
85	CM-204	TAXIWAY A PAVEMENT MARKING PLAN 4
86	CM-205	TAXIWAY A PAVEMENT MARKING PLAN 5
87	CM-206	TAXIWAY A PAVEMENT MARKING PLAN 6
88	CM-207	CONNECTOR TAXIWAY A PAVEMENT MARKING PLAN 7
89	CM-301	TAXIWAY G PAVEMENT MARKING PLAN
90	CM-401	TAXIWAY D PAVEMENT MARKING PLAN
91	CM-402	TAXIWAY D PAVEMENT MARKING PLAN 1 (ADDITIVE ALTERNATE 1)
92	CM-403	TAXIWAY D PAVEMENT MARKING PLAN 2 (ADDITIVE ALTERNATE 1)
93	CM-501	RUNWAY 2-20 PAVEMENT MARKING PLAN
94	CM-601	TAXIWAYS C & H PAVEMENT MARKING PLAN
95	CM-701	TAXIWAY B PAVEMENT MARKING PLAN
96	CM-901	PAVEMENT MARKING DETAILS 1
97	CM-902	PAVEMENT MARKING DETAILS 2
ELECTRICAL		
98	EN-001	LIGHTING LEGEND & GENERAL NOTES
99	ED-101	RUNWAY 16-34 AND TAXIWAY A LIGHTING REMOVAL PLAN 1
100	ED-102	RUNWAY 16-34 AND TAXIWAY A LIGHTING REMOVAL PLAN 2
101	ED-103	RUNWAY 16-34 AND TAXIWAY A LIGHTING REMOVAL PLAN 3
102	ED-104	RUNWAY 16-34 AND TAXIWAY A LIGHTING REMOVAL PLAN 4
103	ED-201	LIGHTING REMOVAL DETAILS
104	EL-101	RUNWAY 16-34 AND TAXIWAY A LIGHTING INSTALLATION PLAN 1
105	EL-102	RUNWAY 16-34 AND TAXIWAY A LIGHTING INSTALLATION PLAN 2
106	EL-103	RUNWAY 16-34 AND TAXIWAY A LIGHTING INSTALLATION PLAN 3
107	EL-104	RUNWAY 16-34 AND TAXIWAY A LIGHTING INSTALLATION PLAN 4
108	EL-201	LIGHTING INSTALLATION DETAILS 1
109	EL-202	LIGHTING INSTALLATION DETAILS 2
110	EL-203	LIGHTING INSTALLATION DETAILS 3
111	EL-204	LIGHTING INSTALLATION DETAILS 4
112	EL-205	LIGHTING INSTALLATION DETAILS 5
113	EL-206	LIGHTING INSTALLATION DETAILS 6
114	EL-207	LIGHTING INSTALLATION DETAILS 7
115	EL-208	LIGHTING INSTALLATION DETAILS 8
116	EL-209	LIGHTING INSTALLATION DETAILS 9
CROSS SECTIONS		
117	XS-101	RUNWAY 16-34 CROSS SECTIONS 1
118	XS-102	RUNWAY 16-34 CROSS SECTIONS 2
119	XS-103	RUNWAY 16-34 CROSS SECTIONS 3
120	XS-104	RUNWAY 16-34 CROSS SECTIONS 4
121	XS-105	RUNWAY 16-34 CROSS SECTIONS 5
122	XS-106	RUNWAY 16-34 CROSS SECTIONS 6
123	XS-107	RUNWAY 16-34 CROSS SECTIONS 7
124	XS-108	RUNWAY 16-34 CROSS SECTIONS 8
125	XS-109	RUNWAY 16-34 CROSS SECTIONS 9
126	XS-110	RUNWAY 16-34 CROSS SECTIONS 10
127	XS-111	RUNWAY 16-34 CROSS SECTIONS 11
128	XS-112	RUNWAY 16-34 CROSS SECTIONS 12
129	XS-113	RUNWAY 16-34 CROSS SECTIONS 13
130	XS-114	RUNWAY 16-34 CROSS SECTIONS 14
131	XS-115	RUNWAY 16-34 CROSS SECTIONS 15
132	XS-116	RUNWAY 16-34 CROSS SECTIONS 16
133	XS-117	RUNWAY 16-34 CROSS SECTIONS 17
134	XS-118	RUNWAY 16-34 CROSS SECTIONS 18
135	XS-119	RUNWAY 16-34 CROSS SECTIONS 19
136	XS-120	RUNWAY 16-34 CROSS SECTIONS 20
137	XS-121	RUNWAY 16-34 CROSS SECTIONS 21
138	XS-122	RUNWAY 16-34 CROSS SECTIONS 22
139	XS-123	RUNWAY 16-34 CROSS SECTIONS 23
140	XS-124	RUNWAY 16-34 CROSS SECTIONS 24
141	XS-125	RUNWAY 16-34 CROSS SECTIONS 25
142	XS-126	RUNWAY 16-34 CROSS SECTIONS 26
143	XS-201	TAXIWAY A CROSS SECTIONS 1
144	XS-202	TAXIWAY A CROSS SECTIONS 2
145	XS-203	TAXIWAY A CROSS SECTIONS 3
146	XS-204	TAXIWAY A CROSS SECTIONS 4

Sheet List Table		
Sheet Number	Drawing Number	Sheet Title
147	XS-205	TAXIWAY A CROSS SECTIONS 5
148	XS-206	TAXIWAY A CROSS SECTIONS 6
149	XS-207	TAXIWAY A CROSS SECTIONS 7
150	XS-208	TAXIWAY A CROSS SECTIONS 8
151	XS-209	TAXIWAY A CROSS SECTIONS 9
152	XS-210	TAXIWAY A CROSS SECTIONS 10
153	XS-211	TAXIWAY A CROSS SECTIONS 11
154	XS-212	TAXIWAY A CROSS SECTIONS 12
155	XS-213	TAXIWAY A CROSS SECTIONS 13
156	XS-214	TAXIWAY A CROSS SECTIONS 14
157	XS-215	TAXIWAY A CROSS SECTIONS 15
158	XS-216	TAXIWAY A CROSS SECTIONS 16
159	XS-217	TAXIWAY A CROSS SECTIONS 17
160	XS-218	TAXIWAY A CROSS SECTIONS 18
161	XS-219	TAXIWAY A CROSS SECTIONS 19
162	XS-301	TAXIWAY G CROSS SECTIONS 1
163	XS-302	TAXIWAY G CROSS SECTIONS 2
164	XS-303	TAXIWAY G CROSS SECTIONS 3
165	XS-304	TAXIWAY G CROSS SECTIONS 4
166	XS-305	TAXIWAY G CROSS SECTIONS 5
167	XS-401	TAXIWAY D CROSS SECTIONS 1
168	XS-402	TAXIWAY D CROSS SECTIONS 2
169	XS-403	TAXIWAY D CROSS SECTIONS 3
170	XS-404	TAXIWAY D CROSS SECTIONS 4
171	XS-405	TAXIWAY D CROSS SECTIONS 5
172	XS-406	TAXIWAY D CROSS SECTIONS 6
173	XS-501	RUNWAY 2-20 CROSS SECTIONS 1
174	XS-502	RUNWAY 2-20 CROSS SECTIONS 2
175	XS-503	RUNWAY 2-20 CROSS SECTIONS 3
176	XS-504	RUNWAY 2-20 CROSS SECTIONS 4
177	XS-505	RUNWAY 2-20 CROSS SECTIONS 5
178	XS-506	RUNWAY 2-20 CROSS SECTIONS 6
179	XS-601	TAXIWAY H CROSS SECTIONS 1
180	XS-602	TAXIWAY H CROSS SECTIONS 2
181	XS-701	TAXIWAY C CROSS SECTIONS 1
182	XS-702	TAXIWAY C CROSS SECTIONS 2
183	XS-801	TAXIWAY B CROSS SECTIONS 1
184	XS-802	TAXIWAY B CROSS SECTIONS 2
185	XS-901	TAXIWAY D (ADDITIVE ALTERNATE 1) CROSS SECTIONS 1
186	XS-902	TAXIWAY D (ADDITIVE ALTERNATE 1) CROSS SECTIONS 2
187	XS-903	TAXIWAY D (ADDITIVE ALTERNATE 1) CROSS SECTIONS 3
188	XS-904	TAXIWAY D (ADDITIVE ALTERNATE 1) CROSS SECTIONS 4
189	XS-905	TAXIWAY D (ADDITIVE ALTERNATE 1) CROSS SECTIONS 5
190	XS-906	TAXIWAY D (ADDITIVE ALTERNATE 1) CROSS SECTIONS 6
191	XS-907	TAXIWAY D (ADDITIVE ALTERNATE 1) CROSS SECTIONS 7
192	XS-908	TAXIWAY D (ADDITIVE ALTERNATE 1) CROSS SECTIONS 8
193	XS-909	TAXIWAY D (ADDITIVE ALTERNATE 1) CROSS SECTIONS 9



© 2023 GARVER, LLC  
THIS DOCUMENT, ALONG WITH THE IDEAS AND DESIGNS CONVEYED HEREIN, SHALL BE CONSIDERED INSTRUMENTS OF PROFESSIONAL SERVICE AND ARE PROPERTY OF GARVER, LLC. ANY USE, REPRODUCTION, OR DISTRIBUTION OF THIS DOCUMENT, ALONG WITH THE IDEAS AND DESIGN CONTAINED HEREIN, IS PROHIBITED UNLESS AUTHORIZED IN WRITING BY GARVER, LLC OR EXPLICITLY ALLOWED IN THE GOVERNING PROFESSIONAL SERVICES AGREEMENT FOR THIS WORK.

BY:	AMJ		
DESCRIPTION:	ADDENDUM NO. 2		
DATE:	6/6/23		
REV:	1		



ANDREWS COUNTY  
AIRPORT  
ANDREWS, TEXAS

RUNWAY 16 AND TAXIWAY A  
RECONSTRUCTION

SHEET INDEX

JOB NO.: 22A11972  
DATE: JAN 2023  
DESIGNED BY: JAH  
DRAWN BY: JAH


BAR IS ONE INCH ON ORIGINAL DRAWING  
0 1"  
IF NOT ONE INCH ON THIS SHEET, ADJUST SCALES ACCORDINGLY.


DRAWING NUMBER  
**GI-002**

SHEET NUMBER  
**2**




File: L:\2022\22A11972 - E11 RW 16-34 and TW A Recon\Drawings\E11\_RW\_RHB-GI-101.dwg, Last Save: 6/6/2023 2:25 PM, Last saved by: JAHenderson  
Last plotted by: Henderson, James, A Plot Style: AECmono.ctb Plot Scale: 1:1 Plot Date: 6/6/2023 2:26 PM Plotter used: DWG To PDF.pc3

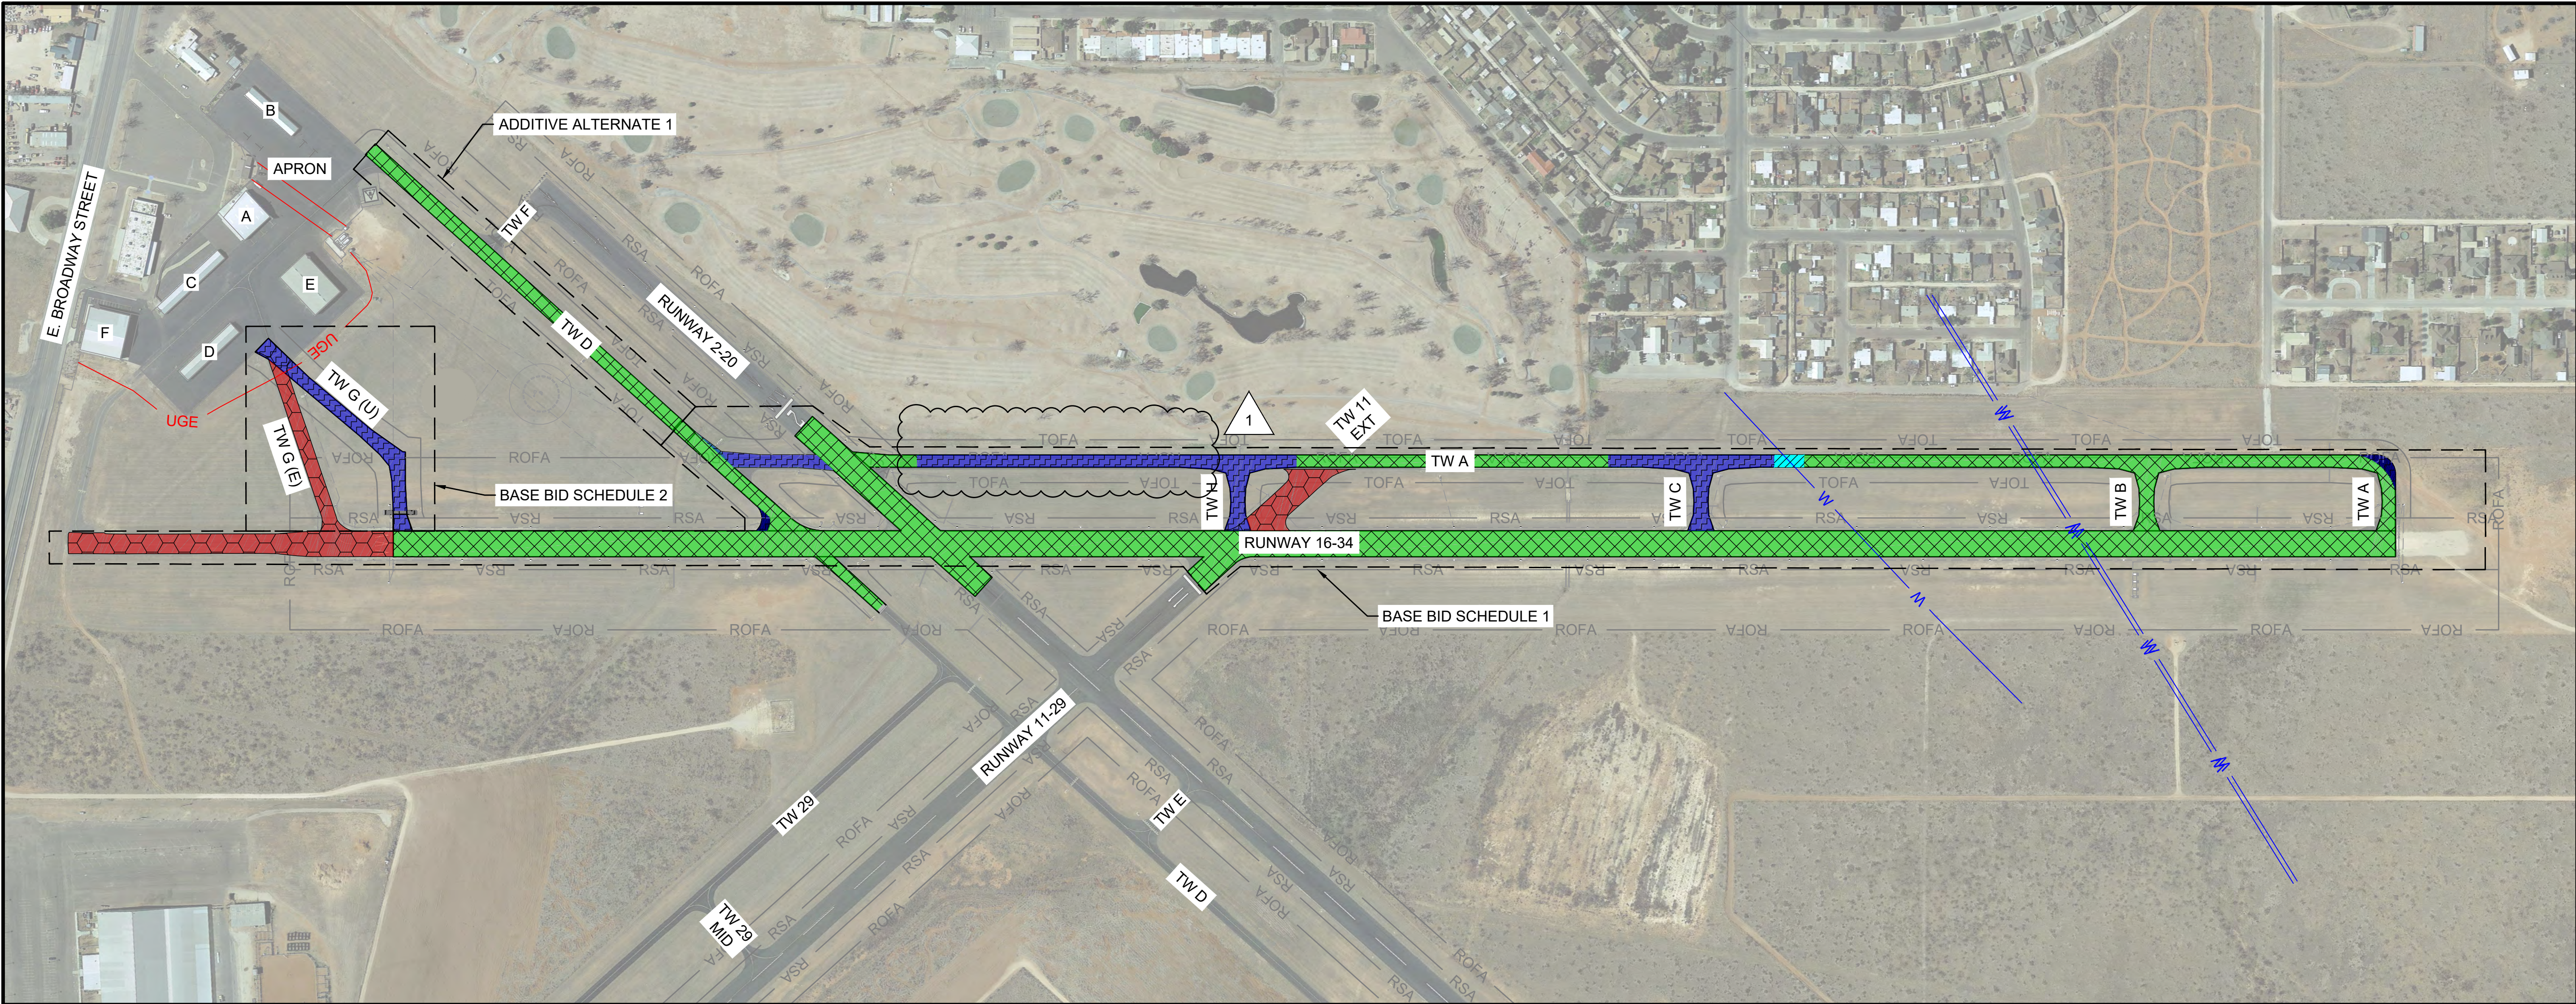



© 2023 GARVER, LLC  
THIS DOCUMENT, ALONG WITH THE IDEAS AND DESIGNS CONVEYED HEREIN, SHALL BE CONSIDERED INSTRUMENTS OF PROFESSIONAL SERVICE AND ARE PROPERTY OF GARVER, LLC. ANY USE, REPRODUCTION, OR DISTRIBUTION OF THIS DOCUMENT, ALONG WITH THE IDEAS AND DESIGN CONTAINED HEREIN, IS PROHIBITED UNLESS AUTHORIZED IN WRITING BY GARVER, LLC OR EXPLICITLY ALLOWED IN THE GOVERNING PROFESSIONAL SERVICES AGREEMENT FOR THIS WORK.

REV.	DATE	DESCRIPTION	BY
1	6/6/23	ADDENDUM NO. 2	AMJ



ANDREWS COUNTY  
AIRPORT  
ANDREWS, TEXAS

RUNWAY 16 AND TAXIWAY A  
RECONSTRUCTION


PROJECT LAYOUT  
PLAN

JOB NO.: 22A11972  
DATE: JAN 2023  
DESIGNED BY: JAH  
DRAWN BY: JAH

BAR IS ONE INCH ON  
ORIGINAL DRAWING  
0 1"  
IF NOT ONE INCH ON THIS SHEET,  
ADJUST SCALES ACCORDINGLY.

DRAWING NUMBER  
**GI-101**

SHEET  
NUMBER **3**

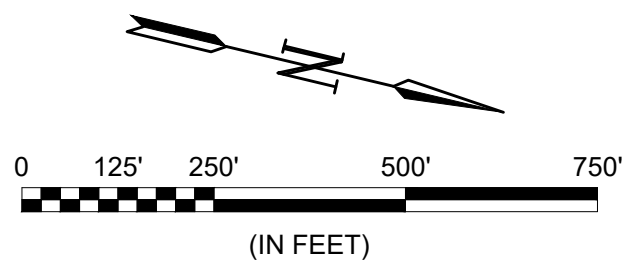

**LEGEND**

RSA

ROFA

TOFA

UGE

W

RUNWAY SAFETY AREA

RUNWAY OBJECT FREE AREA

TAXIWAY OBJECT FREE AREA

UNDERGROUND ELECTRICAL

WATERLINE

**ITEMS OF WORK**

WORK ITEMS FOR CONSTRUCTION INCLUDE BUT NOT LIMITED TO THE FOLLOWING:

**BASE BID SCHEDULE 1:**

1. INSTALL BARRICADES, RUNWAY CLOSURE MARKINGS, AND EROSION CONTROL MEASURES.
2. REMOVE EXISTING ASPHALT PAVEMENT.
3. CONSTRUCT FULL DEPTH RECLAMATION PAVEMENT SECTION FOR RUNWAY 16-34, RUNWAY 2-20 INTERSECTION, AND TAXIWAY A.
4. CONSTRUCT NEW PAVEMENT SECTION FOR TAXIWAY H, TAXIWAY C, AND SECTIONS OF TAXIWAY A.
5. CONSTRUCT PROPOSED EDGE GRADING.
6. INSTALL PROPOSED RUNWAY THRESHOLD LIGHTS AND GUIDANCE SIGNS.
7. INSTALL PROPOSED PAVEMENT MARKINGS.

**BASE BID SCHEDULE 2:**

1. REMOVE EXISTING TAXIWAY G ASPHALT PAVEMENT.
4. CONSTRUCT NEW PAVEMENT SECTION FOR TAXIWAY G.
5. INSTALL PROPOSED DRAINAGE IMPROVEMENTS.
5. CONSTRUCT PROPOSED EDGE GRADING.
6. INSTALL PROPOSED GUIDANCE SIGNS.
7. INSTALL PROPOSED PAVEMENT MARKINGS.

**ADDITIVE ALTERNATE 1:**

1. CONSTRUCT FULL DEPTH RECLAMATION PAVEMENT SECTION FOR TAXIWAY D.
2. CONSTRUCT PROPOSED EDGE GRADING.
3. INSTALL PROPOSED PAVEMENT MARKINGS.

**EARTHWORK**

	BASE BID SCHED 1		BASE BID SCHED 2		ADD ALT 1	
DESCRIPTION	CUT (C.Y.)	FILL (C.Y.)	CUT (C.Y.)	FILL (C.Y.)	CUT (C.Y.)	FILL (C.Y.)
GRADING UNCLASSIFIED EXCAVATION	6,182	9,574	5,309	1,566	109	207

1

- EARTHWORK QUANTITY NOTES:
1. SEE SPECIFICATION P-152 FOR MATERIAL, METHOD OF MEASUREMENT AND PAYMENT.
  2. SEE SPECIFICATION P-101 FOR PAVEMENT REMOVAL.
  3. UNSUITABLE EXCAVATION QUANTITY WAS ESTIMATED BASED ON BORING INFORMATION. CONTRACTOR WILL ONLY BE PAID FOR THIS QUANTITY IF UNSUITABLE MATERIAL IS ENCOUNTERED.


PRINTING NOTE: THIS SHEET SHOULD BE PRINTED IN COLOR







File: L:\2022\22A11972 - E11 RW 16-34 and TW A Recon\Drawings\E11\_RW\_RHB-GI-202.dwg, Last Save: 6/5/2023 7:02 PM, Last saved by: JAHenderson  
Last plotted by: Henderson, James, A Plot Style: AECmono.ctb Plot Date: 6/6/2023 1:43 PM Plotter Used: AutoCAD PDF (General Documentation).pc3

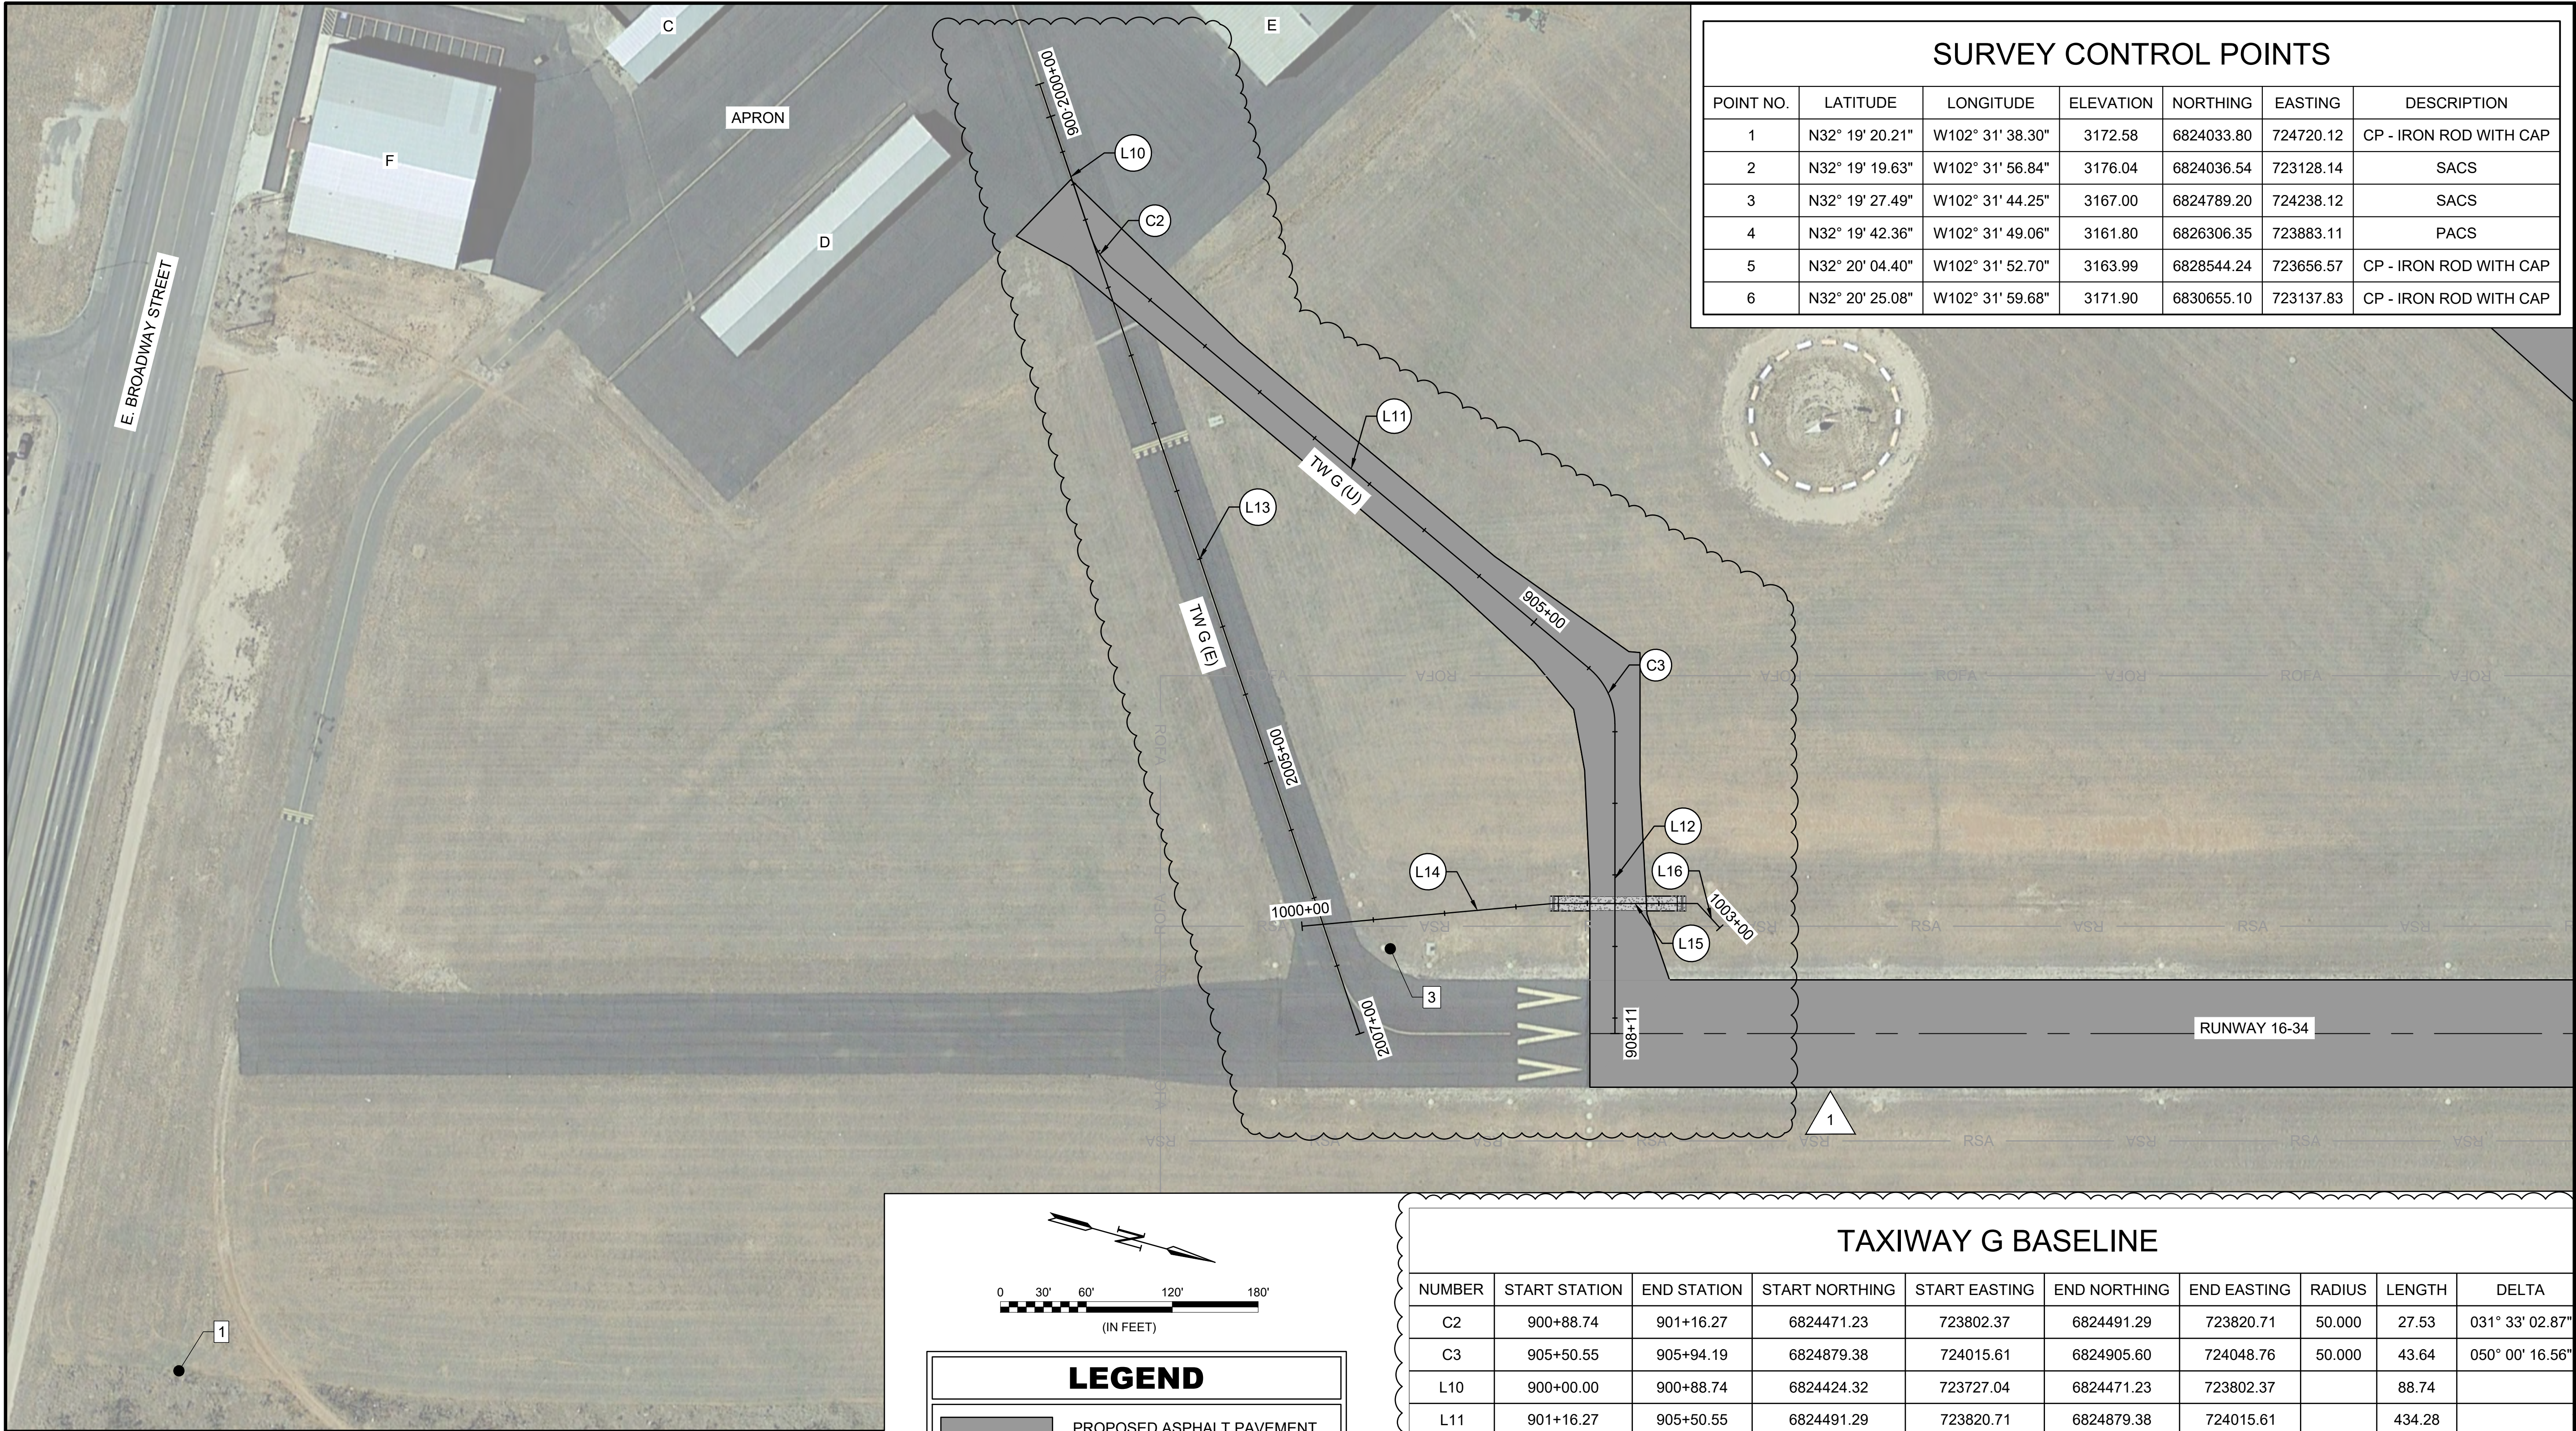

NOTES:

- CONTRACTOR SHALL PROTECT ALL CONTROL POINTS. ANY DAMAGE TO THESE CONTROL POINTS SHALL BE REPAIRED AT NO COST TO THE OWNER. REPAIRS SHALL BE COORDINATED WITH THE ENGINEER AND SHALL BE COMPLETED BY A LICENSED SURVEYOR. FINAL RESULTS OF THE RE-SET MONUMENT SHALL BE SUBMITTED TO THE ENGINEER FOR APPROVAL.
- CONTRACTOR SHALL VERIFY CONTROL POINTS AND NOTIFY ENGINEER OF ANY DISCREPANCIES PRIOR TO BEGINNING CONSTRUCTION.
- BASIS FOR BEARINGS SHOWN HEREON IS THE STATE PLANE COORDINATE SYSTEM, NORTH AMERICAN DATUM OF 1983 (NAD 83), STATE PLAN ZONE 2, ZONE NO. 5351. SURVEY CONDUCTED BY WHITE HAWK ENGINEERING ON 06/17/2022. ALL DISTANCES AND COORDINATES ARE SHOWN IN GRID.
- SURVEY CONTROL POINTS 2, 4, 5, AND 6 ARE NOT SHOWN IN THE VIEW OF THIS SHEET AND ARE PROVIDED FOR REFERENCE IF SURVEY CONTROL POINTS PROVIDED ARE NOT SUFFICIENT TO ESTABLISH PROPER CONTROL.

030'60'120'180'

(IN FEET)

#

PROPOSED ASPHALT PAVEMENT

#

PROPOSED CONCRETE DRAINAGE STRUCTURE

#

SURVEY CONTROL POINT

#

BASELINE POINT

RSA

RUNWAY SAFETY AREA

ROFA

RUNWAY OBJECT FREE AREA

1

TAXIWAY G BASELINE									
NUMBER	START STATION	END STATION	START NORTHING	START EASTING	END NORTHING	END EASTING	RADIUS	LENGTH	DELTA
C2	900+88.74	901+16.27	6824471.23	723802.37	6824491.29	723820.71	50.000	27.53	031° 33' 02.87"
C3	905+50.55	905+94.19	6824879.38	724015.61	6824905.60	724048.76	50.000	43.64	050° 00' 16.56"
L10	900+00.00	900+88.74	6824424.32	723727.04	6824471.23	723802.37		88.74	
L11	901+16.27	905+50.55	6824491.29	723820.71	6824879.38	724015.61		434.28	
L12	905+94.19	908+10.87	6824905.60	724048.76	6824955.55	724259.61		216.68	
TAXIWAY G DEMOLITION BASELINE									
NUMBER	START STATION	END STATION	START NORTHING	START EASTING	END NORTHING	END EASTING	RADIUS	LENGTH	DELTA
L13	2000+00.00	2007+00.00	6824411.61	723706.81	6824782.16	724300.69		700.00	
TW G Drainage Structure									
NUMBER	START STATION	END STATION	START NORTHING	START EASTING	END NORTHING	END EASTING	RADIUS	LENGTH	DELTA
L14	1000+00.00	1001+75.79	6824725.58	724237.02	6824892.27	724181.22		175.79	
L15	1001+75.79	1002+77.00	6824892.27	724181.22	6824990.75	724157.88		101.21	
L16	1002+77.00	1003+00.00	6824990.75	724157.88	6825009.78	724170.80		23.00	

SURVEY CONTROL POINTS						
POINT NO.	LATITUDE	LONGITUDE	ELEVATION	NORTHING	EASTING	DESCRIPTION
1	N32° 19' 20.21"	W102° 31' 38.30"	3172.58	6824033.80	724720.12	CP - IRON ROD WITH CAP
2	N32° 19' 19.63"	W102° 31' 56.84"	3176.04	6824036.54	723128.14	SACS
3	N32° 19' 27.49"	W102° 31' 44.25"	3167.00	6824789.20	724238.12	SACS
4	N32° 19' 42.36"	W102° 31' 49.06"	3161.80	6826306.35	723883.11	PACS
5	N32° 20' 04.40"	W102° 31' 52.70"	3163.99	6828544.24	723656.57	CP - IRON ROD WITH CAP
6	N32° 20' 25.08"	W102° 31' 59.68"	3171.90	6830655.10	723137.83	CP - IRON ROD WITH CAP

GARVER

© 2023 GARVER, LLC  
THIS DOCUMENT, ALONG WITH THE  
IDEAS AND DESIGNS CONVEYED  
HEREIN, SHALL BE CONSIDERED  
INSTRUMENTS OF PROFESSIONAL  
SERVICE AND ARE PROPERTY OF  
GARVER, LLC. ANY USE,  
REPRODUCTION, OR DISTRIBUTION  
OF THIS DOCUMENT, ALONG WITH  
THE IDEAS AND DESIGN CONTAINED  
HEREIN, IS PROHIBITED UNLESS  
AUTHORIZED IN WRITING BY  
GARVER, LLC OR EXPLICITLY  
ALLOWED IN THE GOVERNING  
PROFESSIONAL SERVICES  
AGREEMENT FOR THIS WORK.

BY

AMJ

DESCRIPTION

ADDENDUM NO. 2

DATE

6/6/23

REV.

1

E11

ANDREWS COUNTY  
AIRPORT  
ANDREWS, TEXAS

RUNWAY 16 AND TAXIWAY A  
RECONSTRUCTION

SURVEY CONTROL  
PLAN 2

JOB NO.: 22A11972  
DATE: JAN 2023  
DESIGNED BY: JAH  
DRAWN BY: JAH

BAR IS ONE INCH ON  
ORIGINAL DRAWING  
1"  
NOT ONE INCH ON THIS SHEET.  
ADJUST SCALES ACCORDINGLY.


DRAWING NUMBER  
GI-202

SHEET  
NUMBER 5




File: L:\2022\22A11972 - E11 RW 16-34 and TW A Recon\Drawings\E11\_RW\_RHB-CD-101.dwg Last Save: 6/6/2023 1:30 PM Last saved by: JAHenderson  
Last plotted by: Henderson, James A Plot Style: AECMono.ctb Plot Scale: 1:1 Plot Date: 6/6/2023 1:43 PM Plotter used: AutoCAD PDF (General Documentation).pc3

MATCHLINE STA 117+50.00 SHEET CD-101

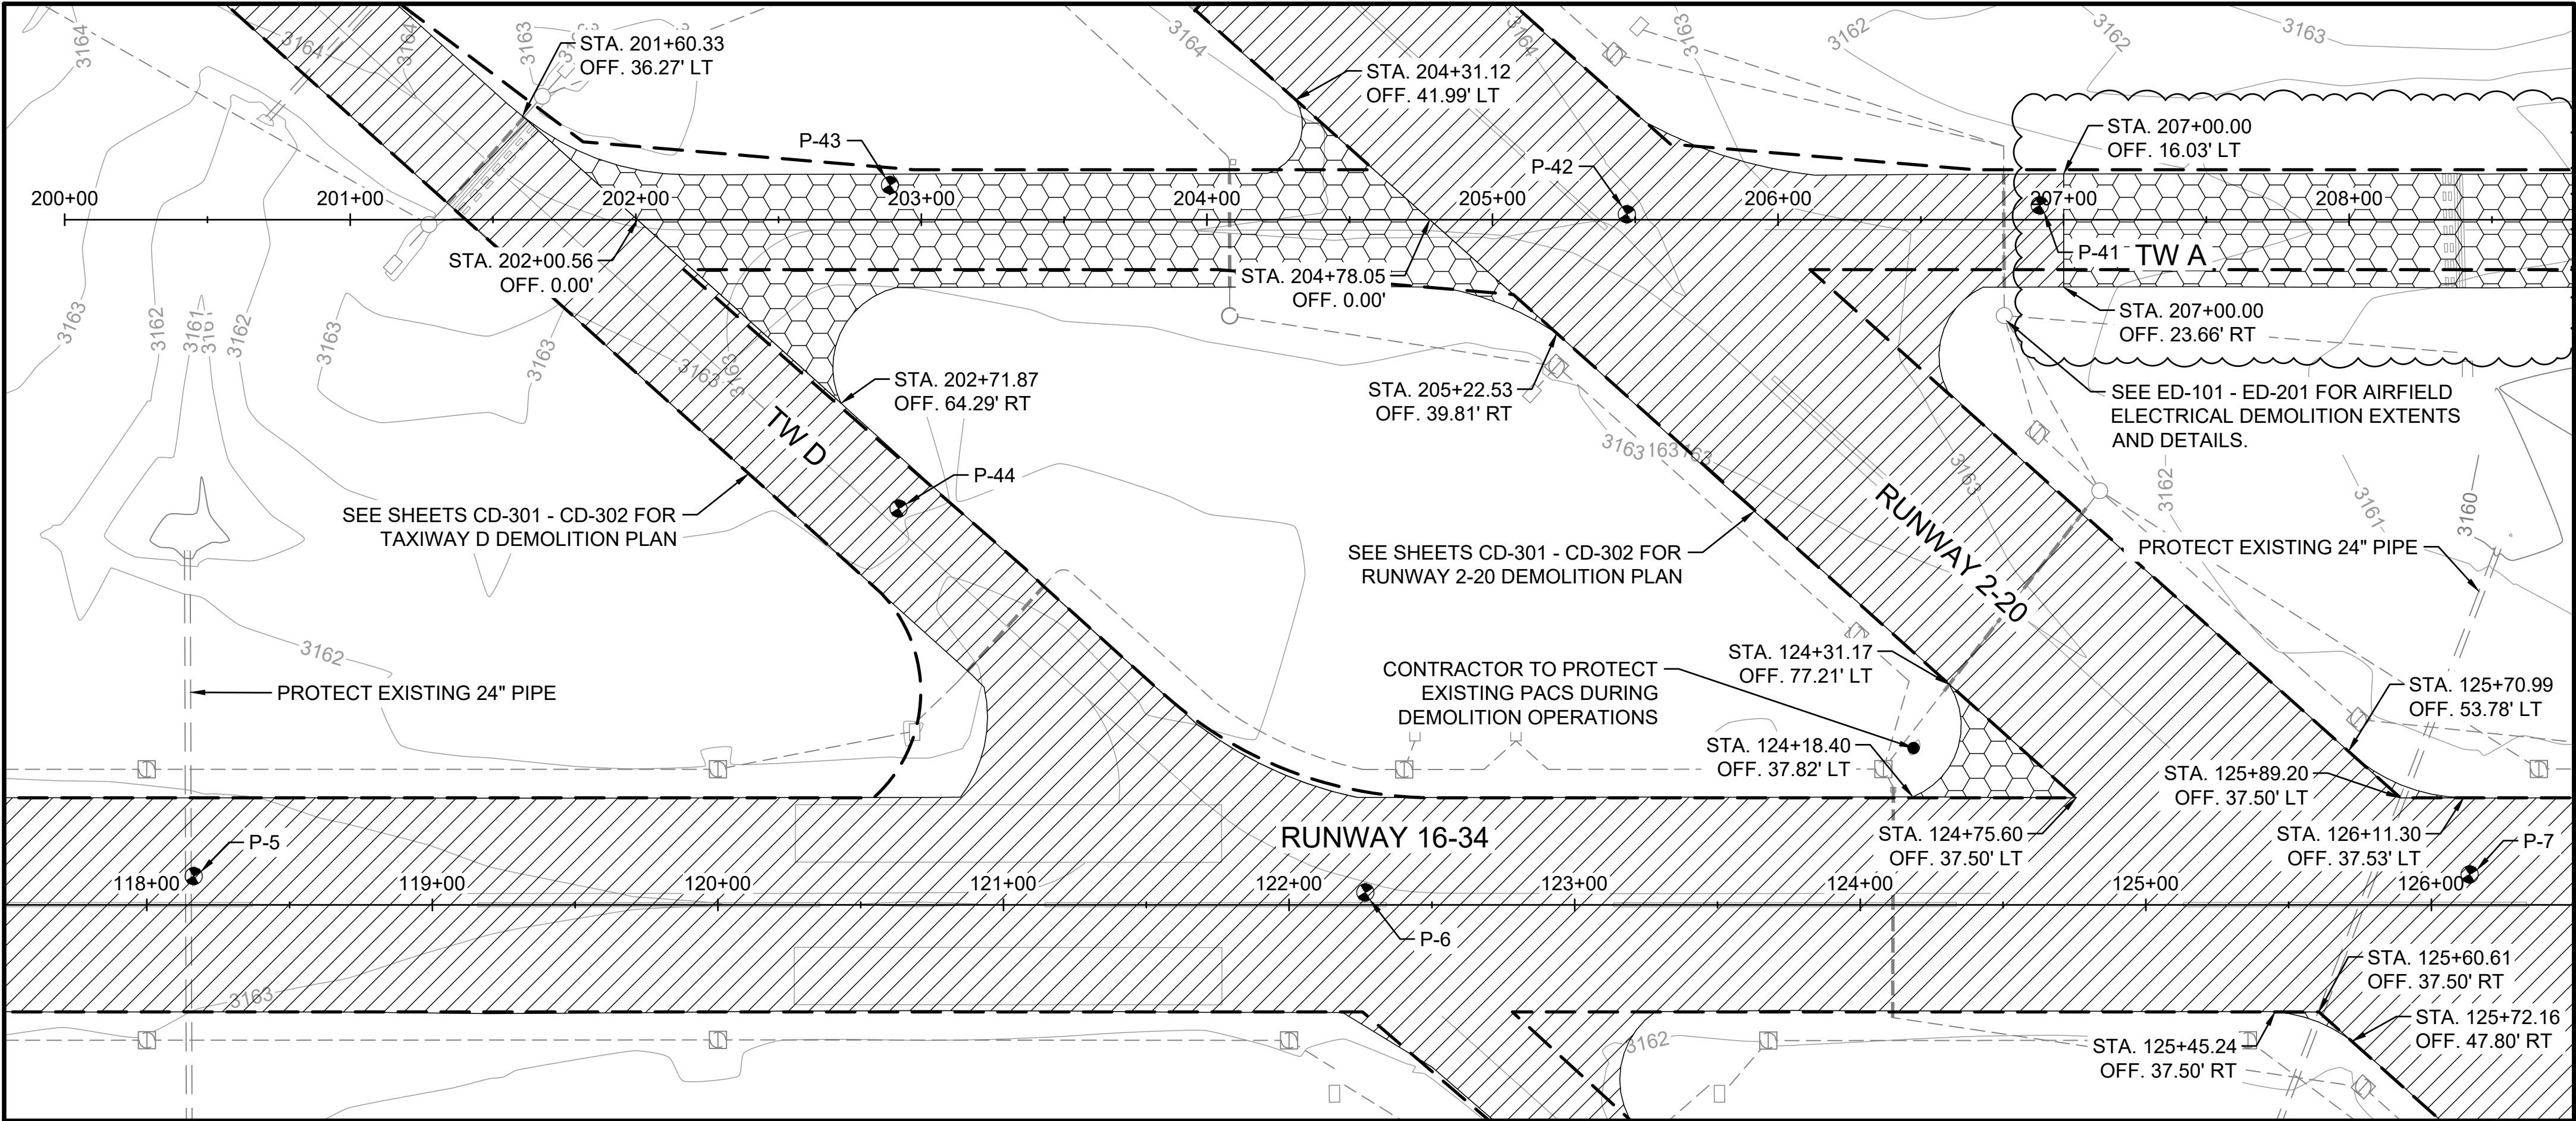

MATCHLINE STA 126+50.00

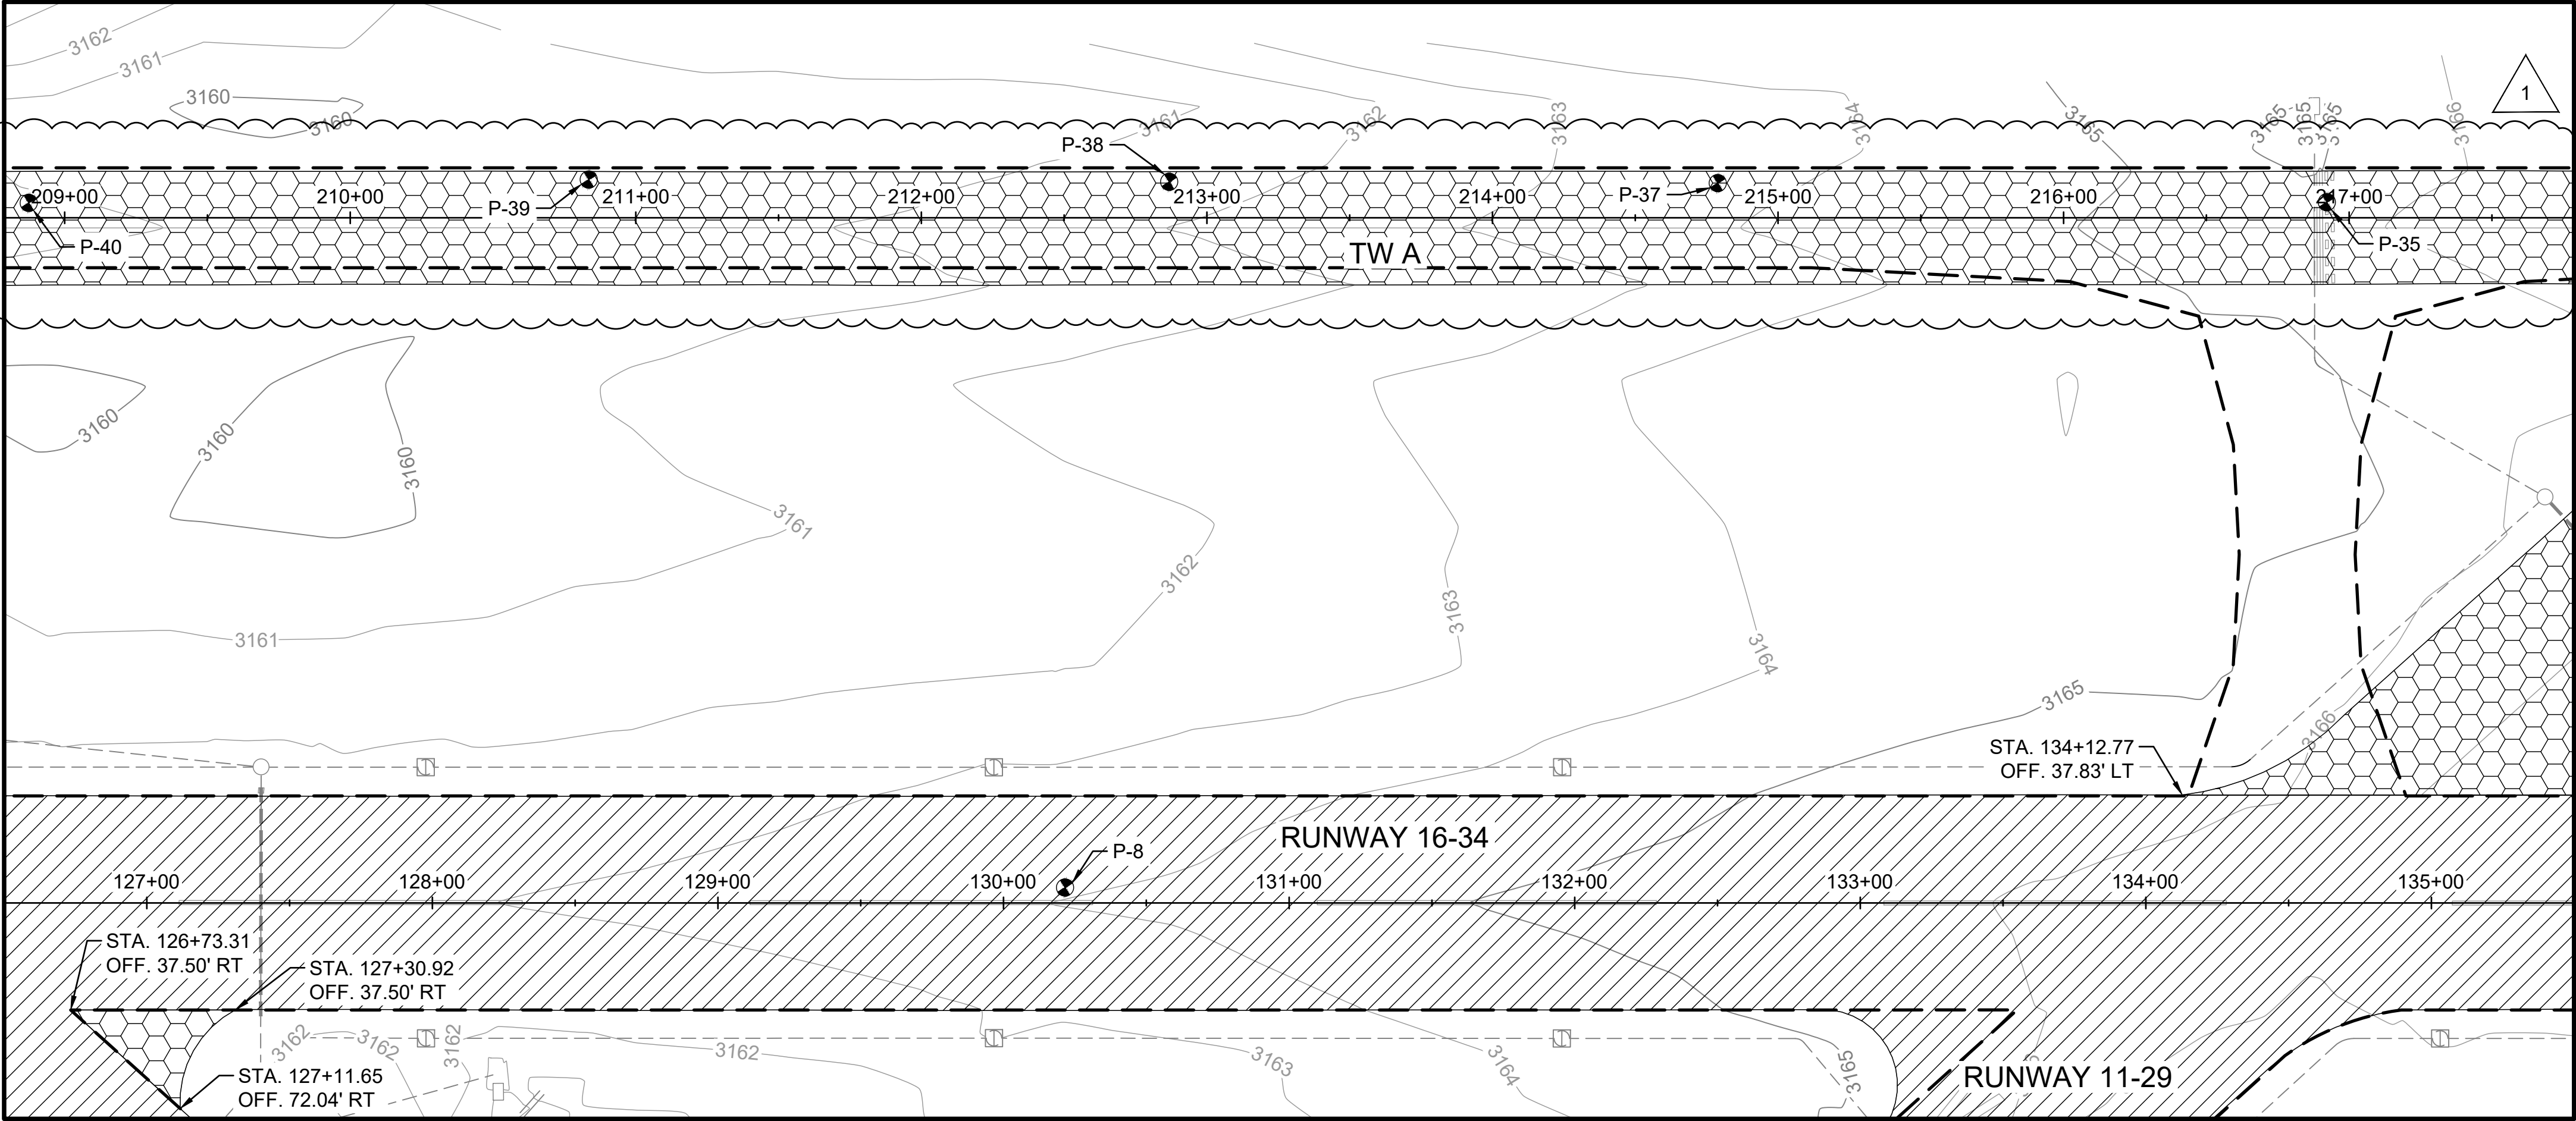

MATCHLINE STA 126+50.00

MATCHLINE STA 135+50.00 SHEET CD-103

### LEGEND

	EXISTING ASPHALT PAVEMENT TO REMAIN
	EXISTING CONTOUR
	ASPHALT PAVEMENT FULL DEPTH RECLAMATION
	ASPHALT PAVEMENT REMOVAL
	EXISTING STORM DRAIN PIPE
	EXISTING RUNWAY LIGHT
	GEOTECHNICAL BORING LOCATION
	PROPOSED PAVEMENT LIMITS

1

CP-005

NOTES:

- CONTRACTOR SHALL PROTECT ALL EXISTING UTILITIES, HAND HOLES, AIRFIELD EQUIPMENT, DRAINAGE STRUCTURES, AND BUILDINGS NOT SHOWN FOR DEMOLITION. ANY DAMAGE AS A RESULT OF CONSTRUCTION ACTIVITIES SHALL BE REPAIRED BY THE CONTRACTOR AT NO COST TO THE OWNER.
- SEE ED-101 - ED-201 FOR AIRFIELD ELECTRICAL DEMOLITION EXTENTS AND DETAILS.
- THE CONTRACTOR SHALL SAWCUT AT THE PROPOSED EDGE OF CONSTRUCTION, AND 6" INSIDE THE PROPOSED EDGE OF EXISTING PAVEMENT. THE CONTRACTOR SHALL NOT REMOVE THE REMAINING 6" PORTION OF PAVEMENT UNTIL NECESSARY FOR CONSTRUCTION OF THE PROPOSED PAVEMENT SECTION.
- CONTRACTOR WILL BE PAID FOR THE SQUARE YARD OF ASPHALT PAVEMENT REMOVED UNDER P-101 TO THE TOP OF PROPOSED SUBGRADE.
- BORING LOG INFORMATION IS BASED ON THE GEOTECHNICAL REPORT PREPARED BY ARIAS IN OCTOBER 2022 . SEE GEOTECHNICAL REPORT FOR DETAILS ON EXISTING SECTIONS.
- REFER TO SHEET CD-101 FOR TEXAS 811 UTILITY PROCEDURES PRIOR TO DEMOLITION WORK.

BORING LOG		
BORING	ASPHALT THICKNESS	BASE COURSE THICKNESS
P-5	4.50"	6.00"
P-6	4.00"	6.00"
P-7	4.50"	6.00"
P-8	4.50"	6.50"
P-35	2.00"	8.00"
P-37	2.00"	8.00"
P-38	2.00"	9.00"
P-39	2.00"	8.00"
P-40	3.00"	7.00"
P-41	2.50"	6.50"
P-42	3.00"	7.00"
P-43	2.50"	7.50"



© 2023 GARVER, LLC  
THIS DOCUMENT, ALONG WITH THE IDEAS AND DESIGNS CONVEYED HEREIN, SHALL BE CONSIDERED INSTRUMENTS OF PROFESSIONAL SERVICE AND ARE PROPERTY OF GARVER, LLC. ANY USE, REPRODUCTION, OR DISTRIBUTION OF THIS DOCUMENT, ALONG WITH THE IDEAS AND DESIGN CONTAINED HEREIN, IS PROHIBITED UNLESS AUTHORIZED IN WRITING BY GARVER, LLC OR EXPLICITLY ALLOWED IN THE GOVERNING PROFESSIONAL SERVICES AGREEMENT FOR THIS WORK.

BY:	AMJ			
DESCRIPTION:	ADDENDUM NO. 2			
DATE:	6/6/23			
REV:	1			

ANDREWS COUNTY AIRPORT  
ANDREWS, TEXAS

RUNWAY 16 AND TAXIWAY A RECONSTRUCTION

RUNWAY 16-34 AND TAXIWAY A DEMOLITION PLAN 2

JOB NO.: 22A11972  
DATE: JAN 2023  
DESIGNED BY: JAH  
DRAWN BY: JAH

BAR IS ONE INCH ON ORIGINAL DRAWING


0 1" IF NOT ONE INCH ON THIS SHEET, ADJUST SCALES ACCORDINGLY.

DRAWING NUMBER  
**CD-102**

SHEET NUMBER  
**18**






File: L:\2022\22A11972 - E11 RW A ReconDrawings\E11\_RW\_RHB-CP-001.dwg, Last Save: 6/6/2023 8:47 AM, Last saved by: JAHenderson  
Last plotted by: Henderson, James, A Plot Style: AECmonochrome.ctb Plot Scale: 1:1 Plot Date: 6/6/2023 1:43 PM Plotter used: AutoCAD PDF (General Documentation).pc3

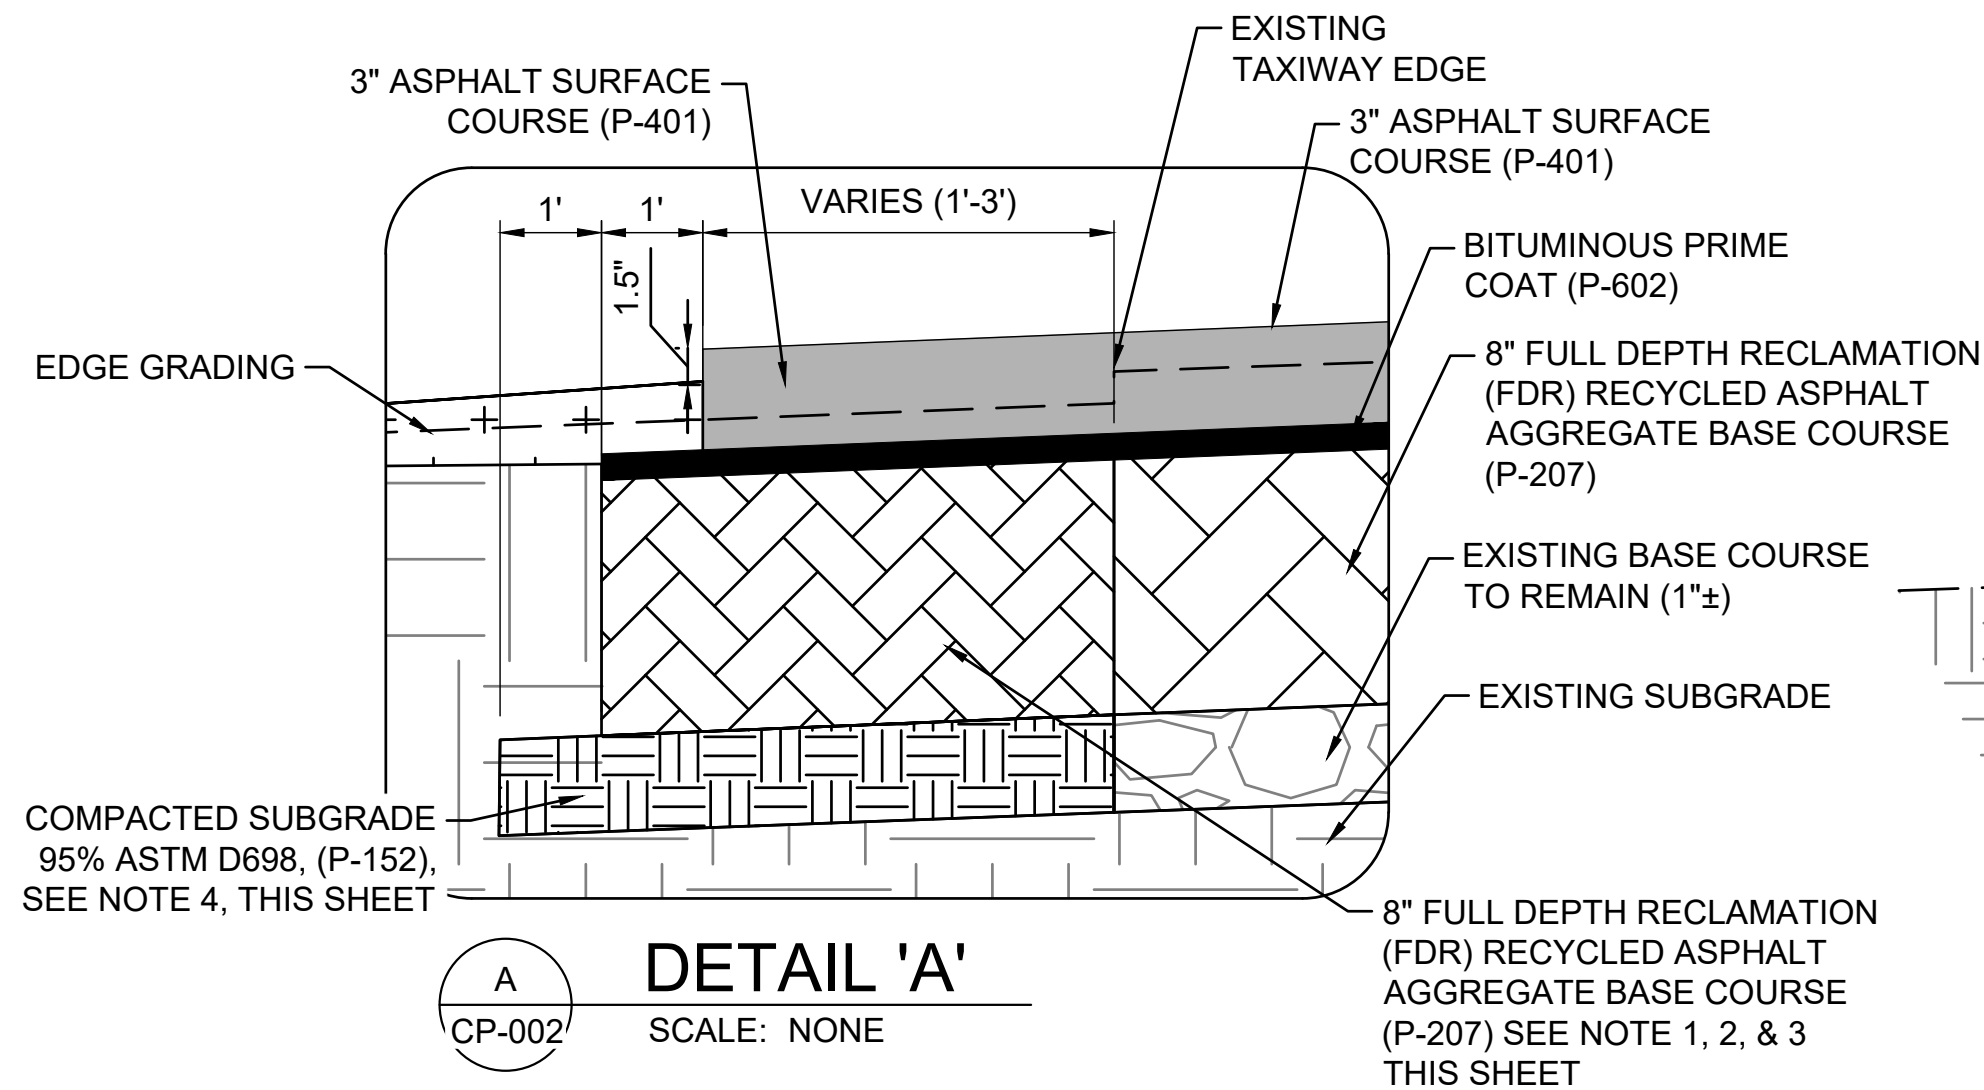

NOTES:

1. ALL EXCAVATION, SUBGRADE PREPARATION, UNDERCUT (IF NECESSARY) AND UNDERCUT BACKFILL (IF NECESSARY) SHALL BE COMPLETED IN WIDENED AREAS PRIOR TO START OF FULL DEPTH RECLAMATION.
2. THE FDR LAYER IN WIDENED AREAS SHALL BE COMPRISED OF APPROXIMATELY 25% MILLED RAP AND 75% AGGREGATE BASE COURSE. THE RAP/AGGREGATE BLEND SHALL BE OBTAINED BY PROCESSING ON-SITE PAVEMENTS SCHEDULED FOR REMOVAL IN THE PLANS.
3. THE CONTRACTOR MAY ELECT TO PLACE UNTREATED RAP/AGGREGATE BLEND IN WIDENED AREAS PRIOR TO BEGINNING OF FDR OPERATIONS. ALTERNATIVELY, THE FDR CONTRACTOR MAY GENERATE EXCESS FDR MATERIAL TO BE TRANSPORTED TO THE WIDENED AREAS DURING CONSTRUCTION.
4. PAVEMENT SUBGRADE IN WIDENED AREAS SHALL BE EVALUATED BY THE RPR DURING CONSTRUCTION. SUBGRADE PREPARATION, INCLUDING UNDERCUT AND BACKFILL, SHALL BE COMPLETED IN ACCORDANCE WITH P-152.

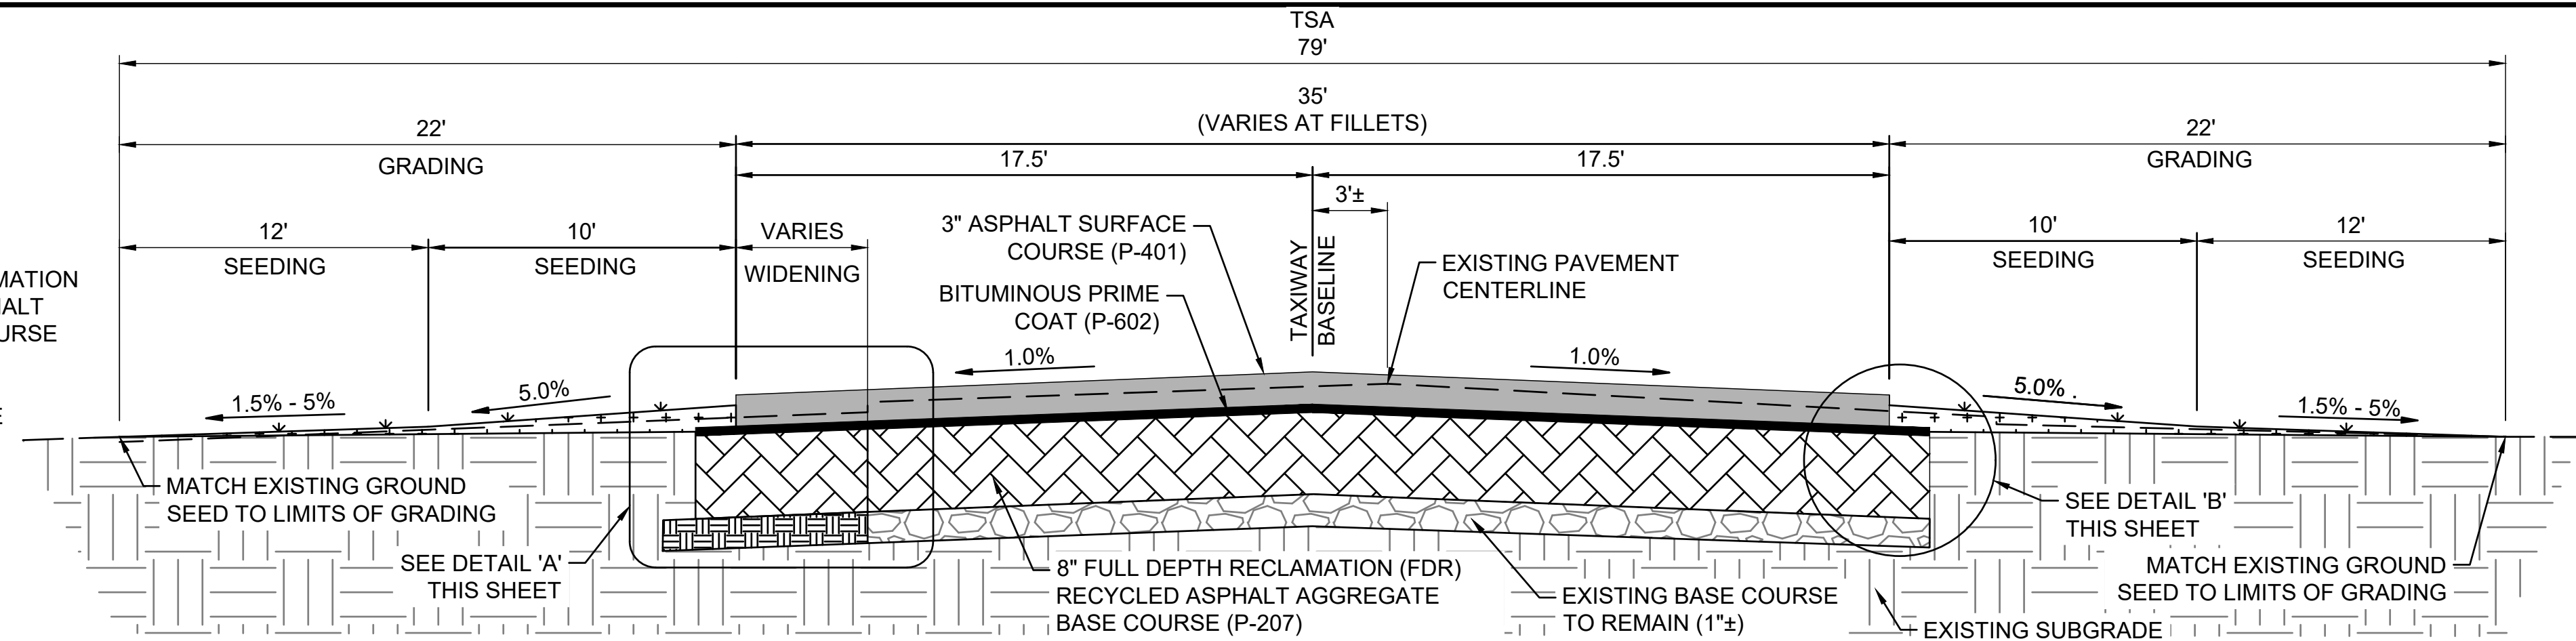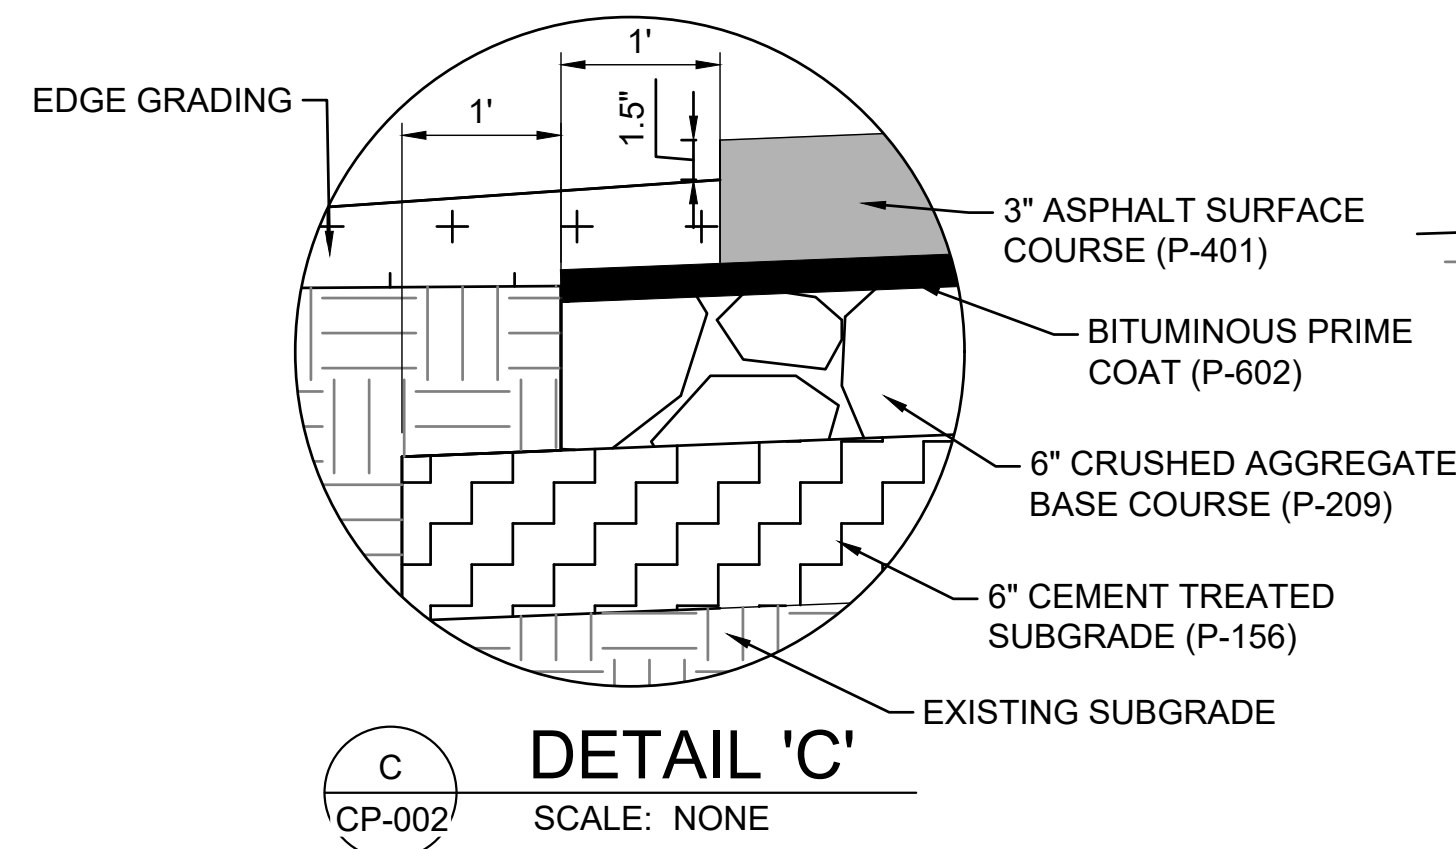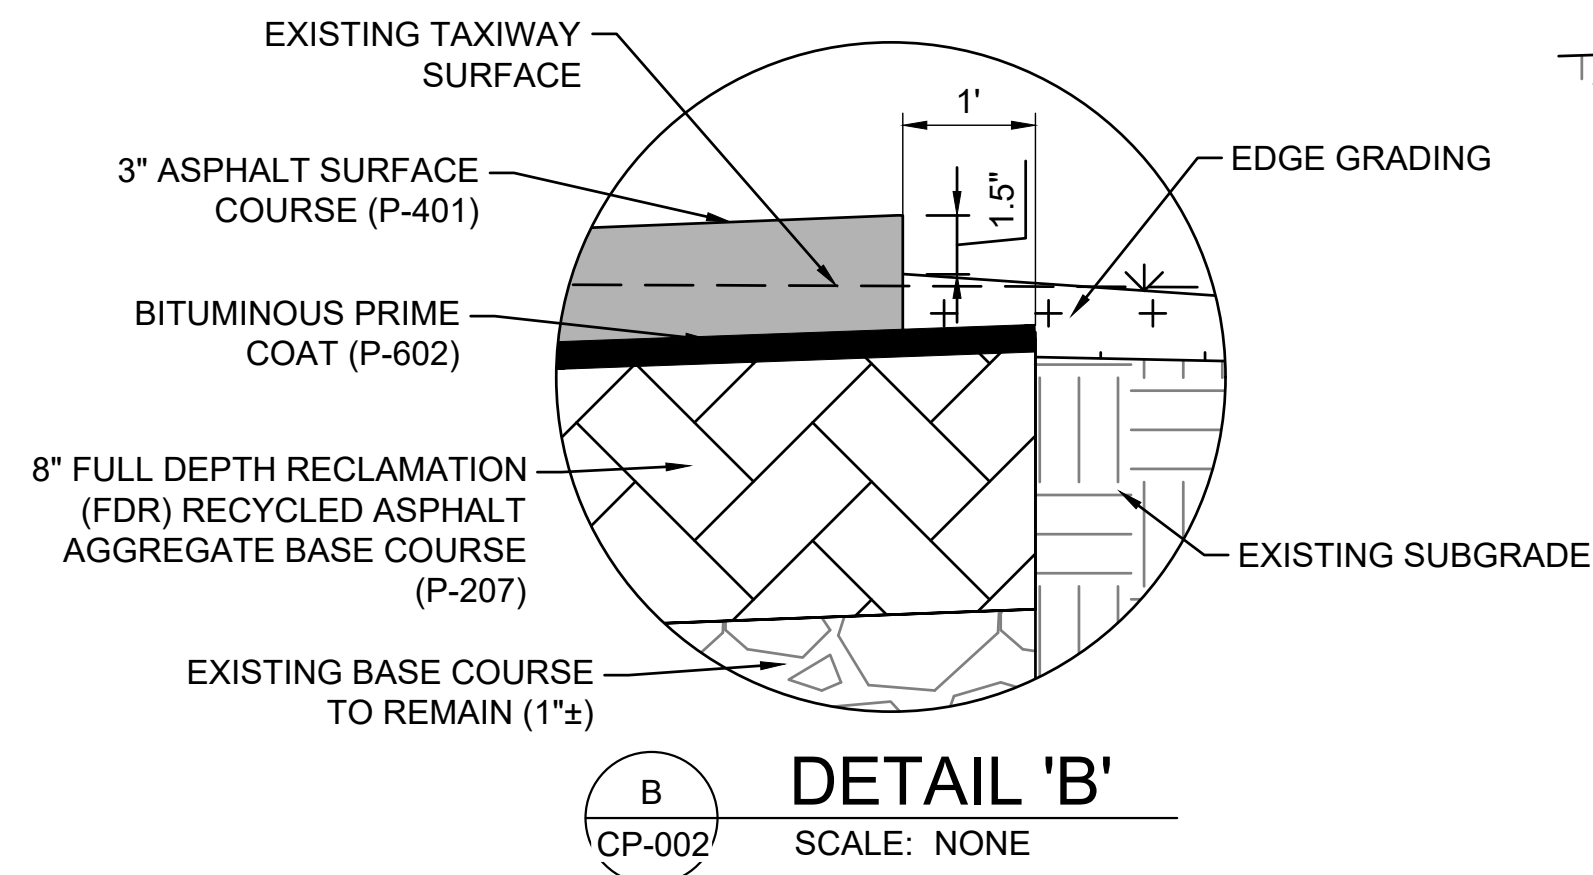

**TAXIWAY A (CROWNED) FULL DEPTH RECLAMATION - TYPICAL SECTION 3**


STA 206+68.90 - STA 215+11.00

STA 218+52.00 - STA 227+57.00

STA 231+97.13 - STA 232+40.00

STA 233+26.00 - STA 251+66.70

**3**  
CP-002 SCALE: NONE

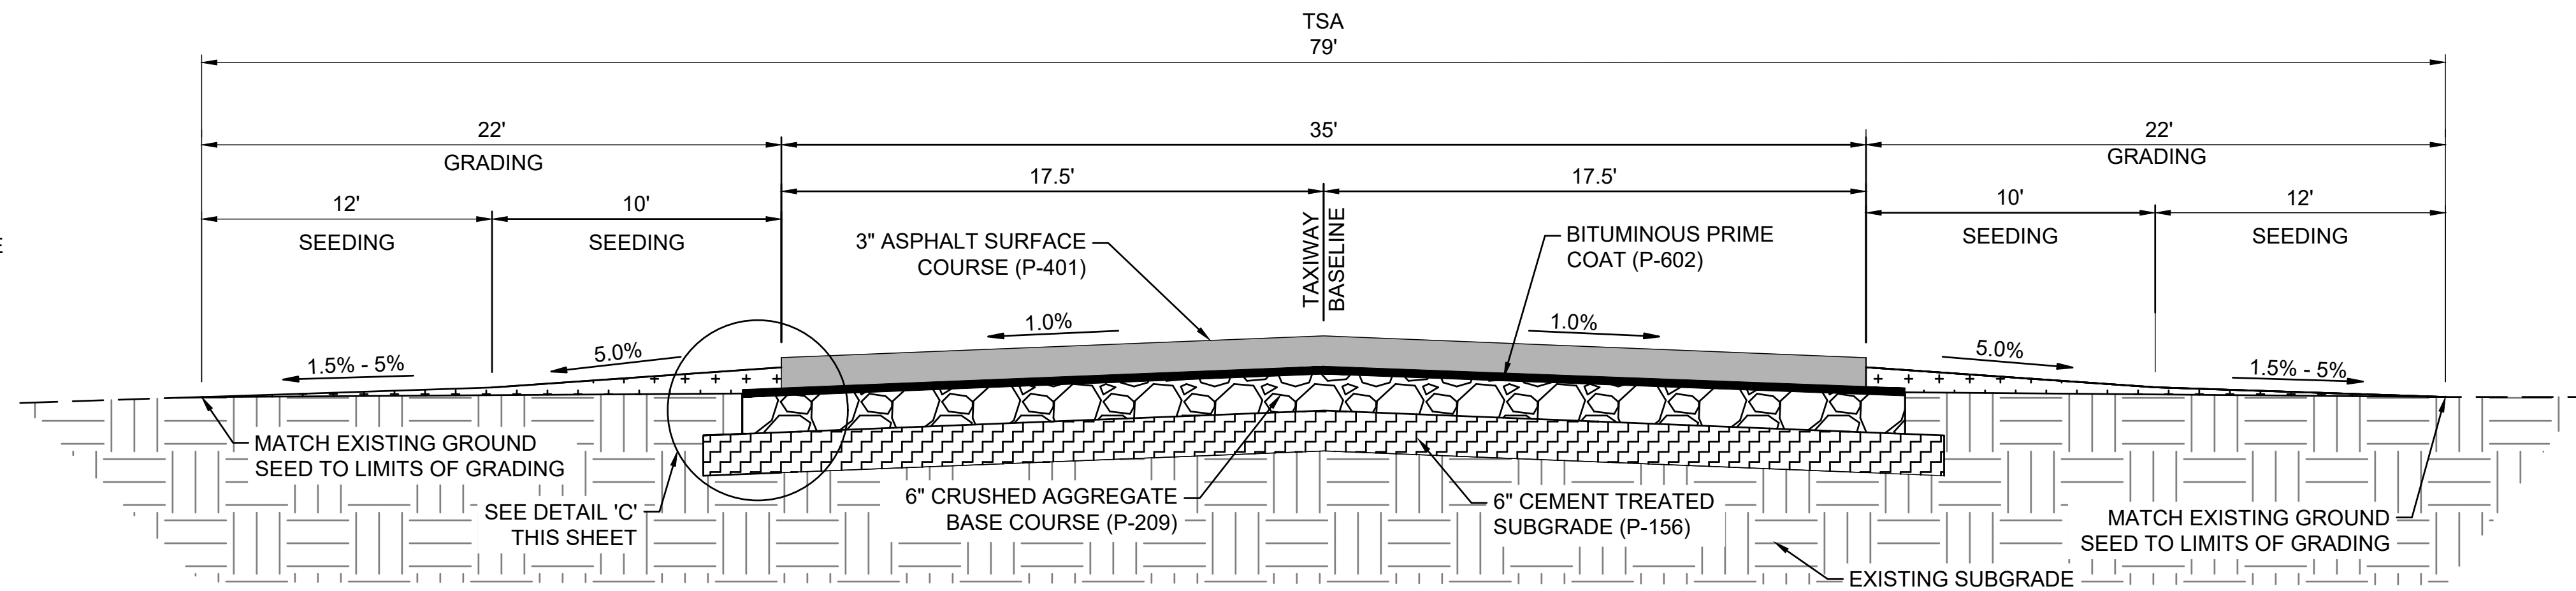


**TAXIWAY A (CROWNED) NEW CONSTRUCTION - TYPICAL SECTION 4**

STA 202+97.44 - STA 204+04.25

STA 207+00.00 - STA 218+52.00

**4**  
CP-002 SCALE: NONE

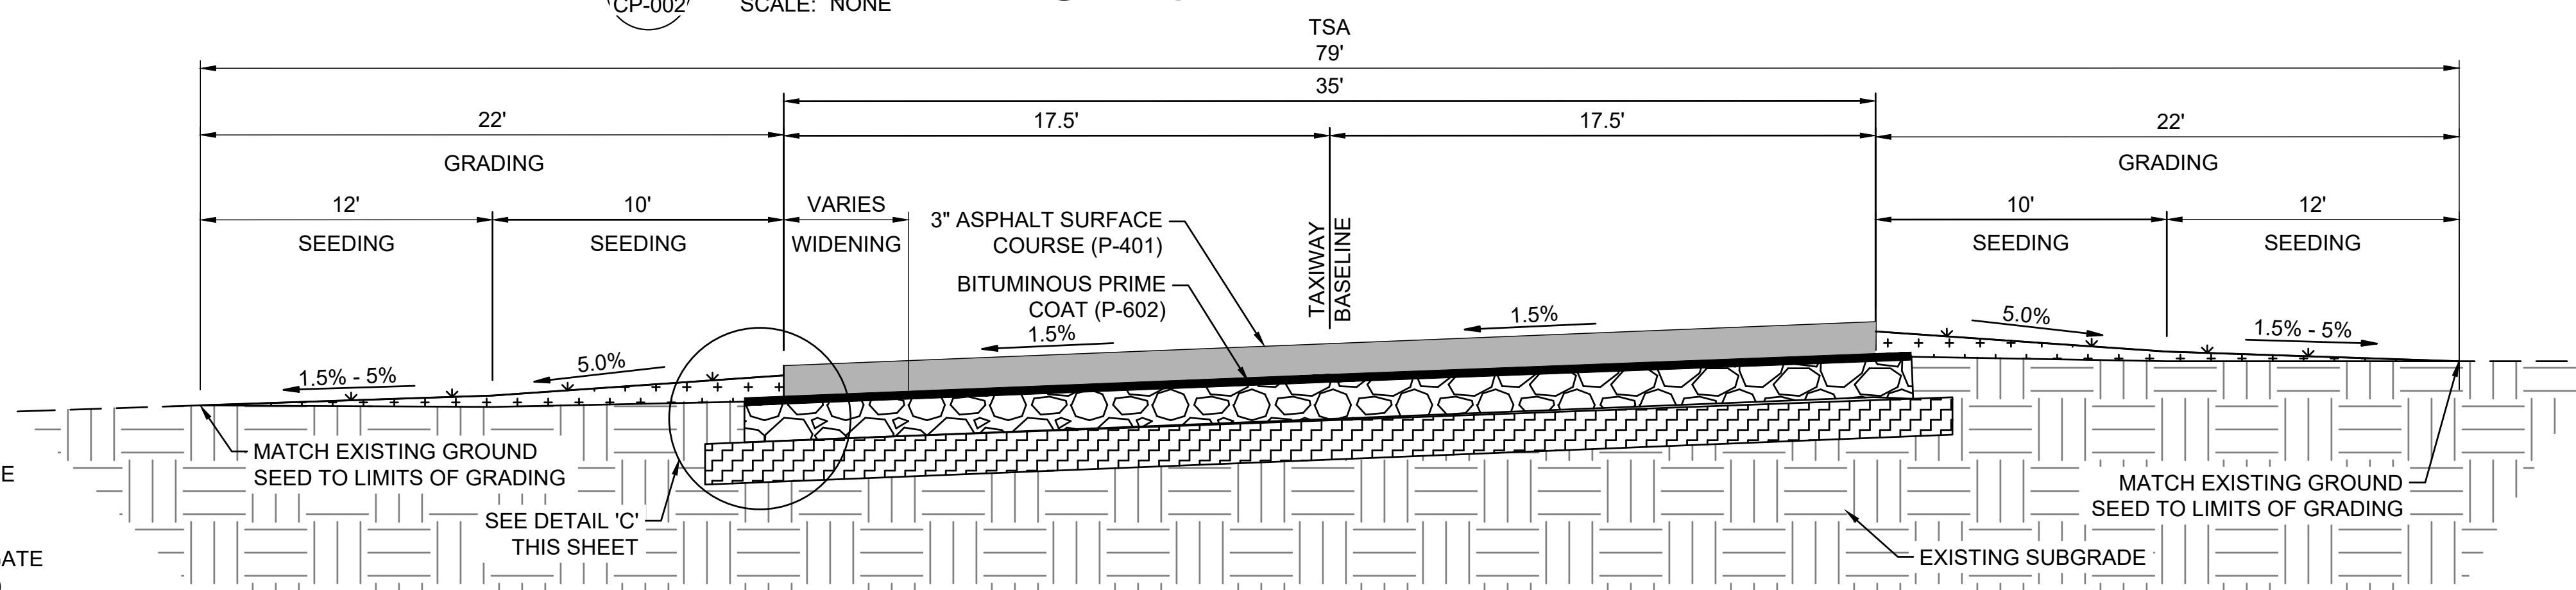

**TAXIWAY A (SUPER ELEVATED) NEW CONSTRUCTION - TYPICAL SECTION 5**

STA 228+56.59 - STA 231+06.41

**5**  
CP-002 SCALE: NONE



© 2023 GARVER, LLC  
THIS DOCUMENT, ALONG WITH THE IDEAS AND DESIGNS CONVEYED HEREIN, SHALL BE CONSIDERED INSTRUMENTS OF PROFESSIONAL SERVICE AND ARE PROPERTY OF GARVER, LLC. ANY USE, REPRODUCTION, OR DISTRIBUTION OF THIS DOCUMENT, ALONG WITH THE IDEAS AND DESIGN CONTAINED HEREIN, IS PROHIBITED UNLESS AUTHORIZED IN WRITING BY GARVER, LLC OR EXPLICITLY ALLOWED IN THE GOVERNING PROFESSIONAL SERVICES AGREEMENT FOR THIS WORK.

BY	AMJ		
DESCRIPTION	ADDENDUM NO. 2		
DATE	6/6/23		
REV.	1		



ANDREWS COUNTY  
AIRPORT  
ANDREWS, TEXAS  
RUNWAY 16 AND TAXIWAY A  
RECONSTRUCTION

TYPICAL SECTIONS 2

JOB NO.: 22A11972  
DATE: JAN 2023  
DESIGNED BY: JAH  
DRAWN BY: JAH

BAR IS ONE INCH ON ORIGINAL DRAWING  
IF NOT ONE INCH ON THIS SHEET, ADJUST SCALES ACCORDINGLY.


DRAWING NUMBER

**CP-002**


SHEET  
NUMBER **25**




File: L:\2022\22A11972 - E11 RW 16-34 and TW A Recon\Drawings\E11\_RW\_RHB-CP-001.dwg, Last Save: 6/6/2023 8:47 AM, Last saved by: JAHenderson  
Last plotted by: Henderson, James, A Plot Style: AECmono.ctb Plot Scale: 1:1 Plot Date: 6/6/2023 1:43 PM Plotter used: AutoCAD PDF (General Documentation).pc3

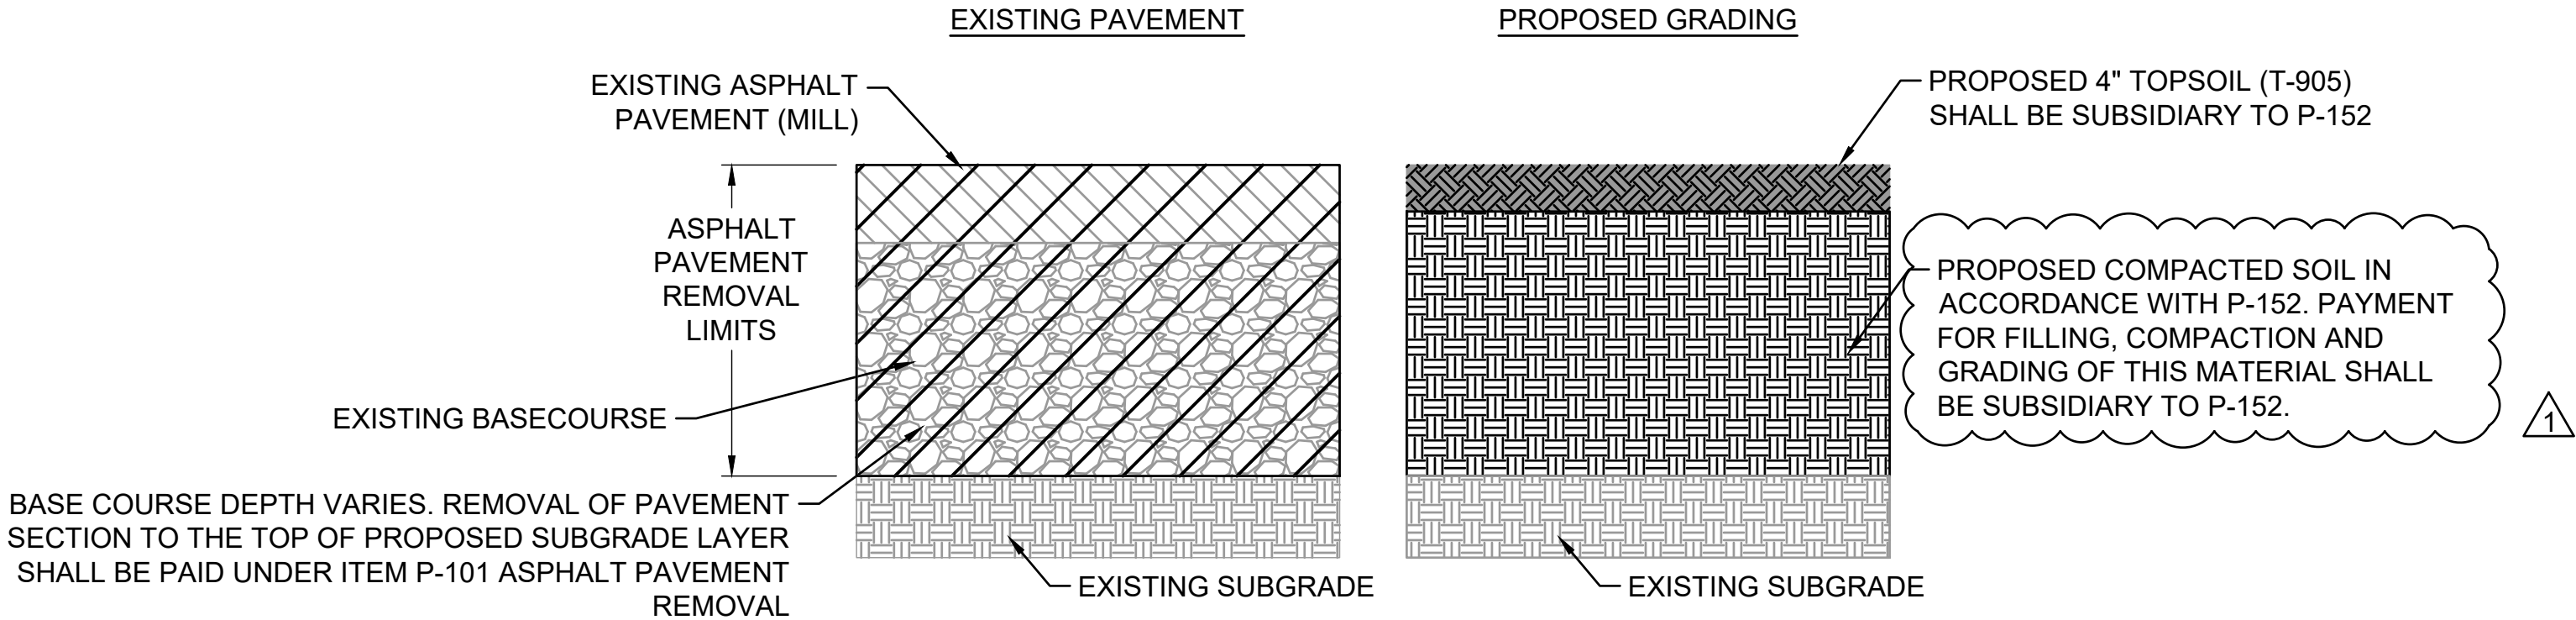


1  
CP-005  
**ASPHALT PAVEMENT REMOVAL DETAIL**  
SCALE: NONE

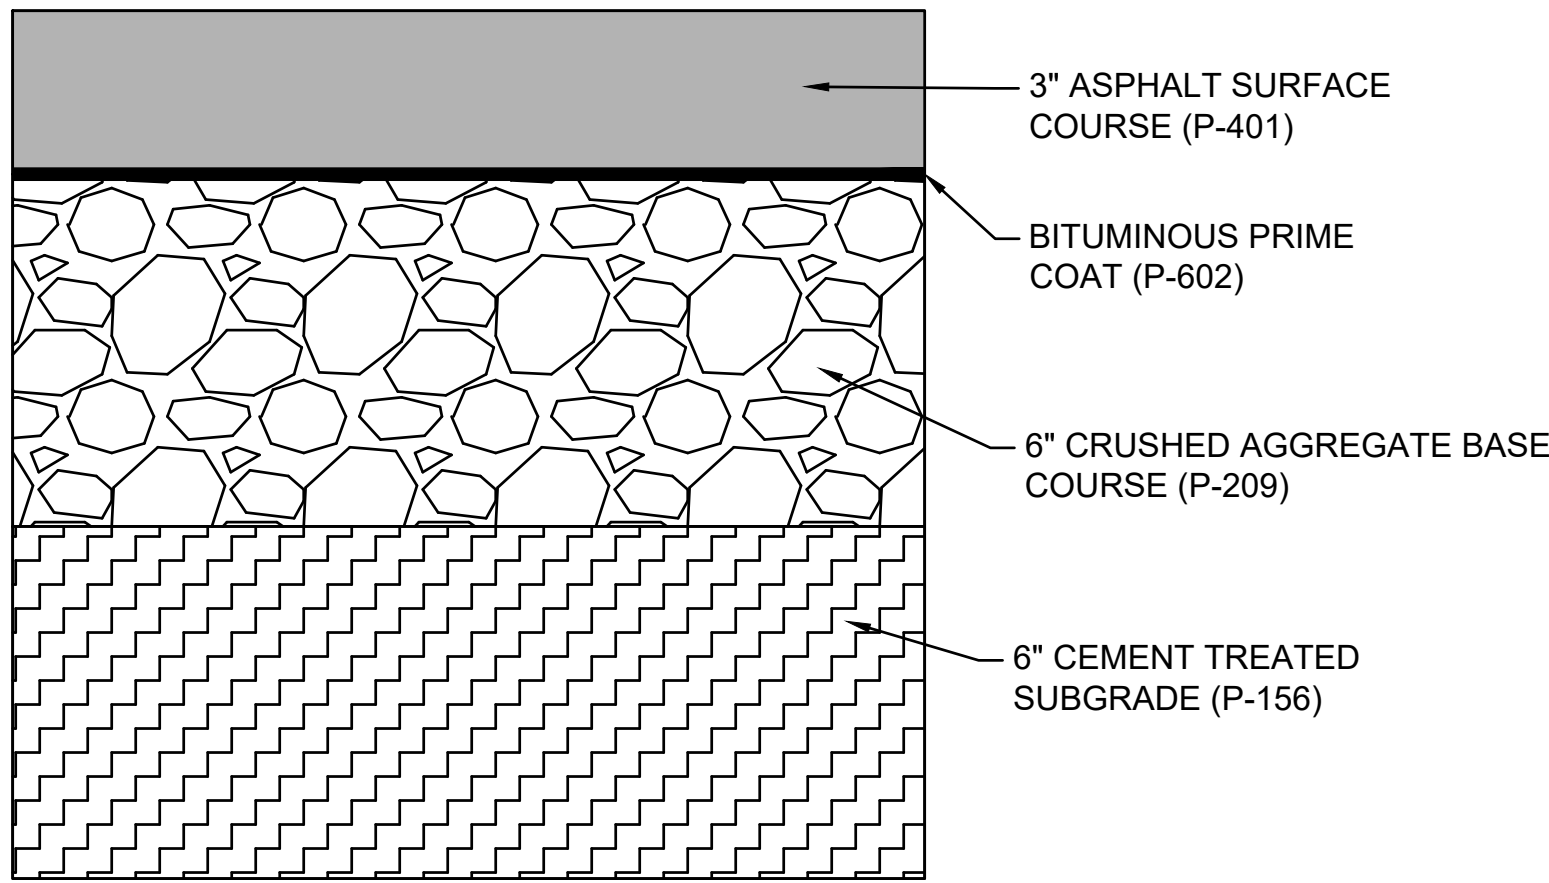


2  
CP-005  
**WIDENING BEYOND FDR LIMITS PAVEMENT SECTION**  
SCALE: NONE

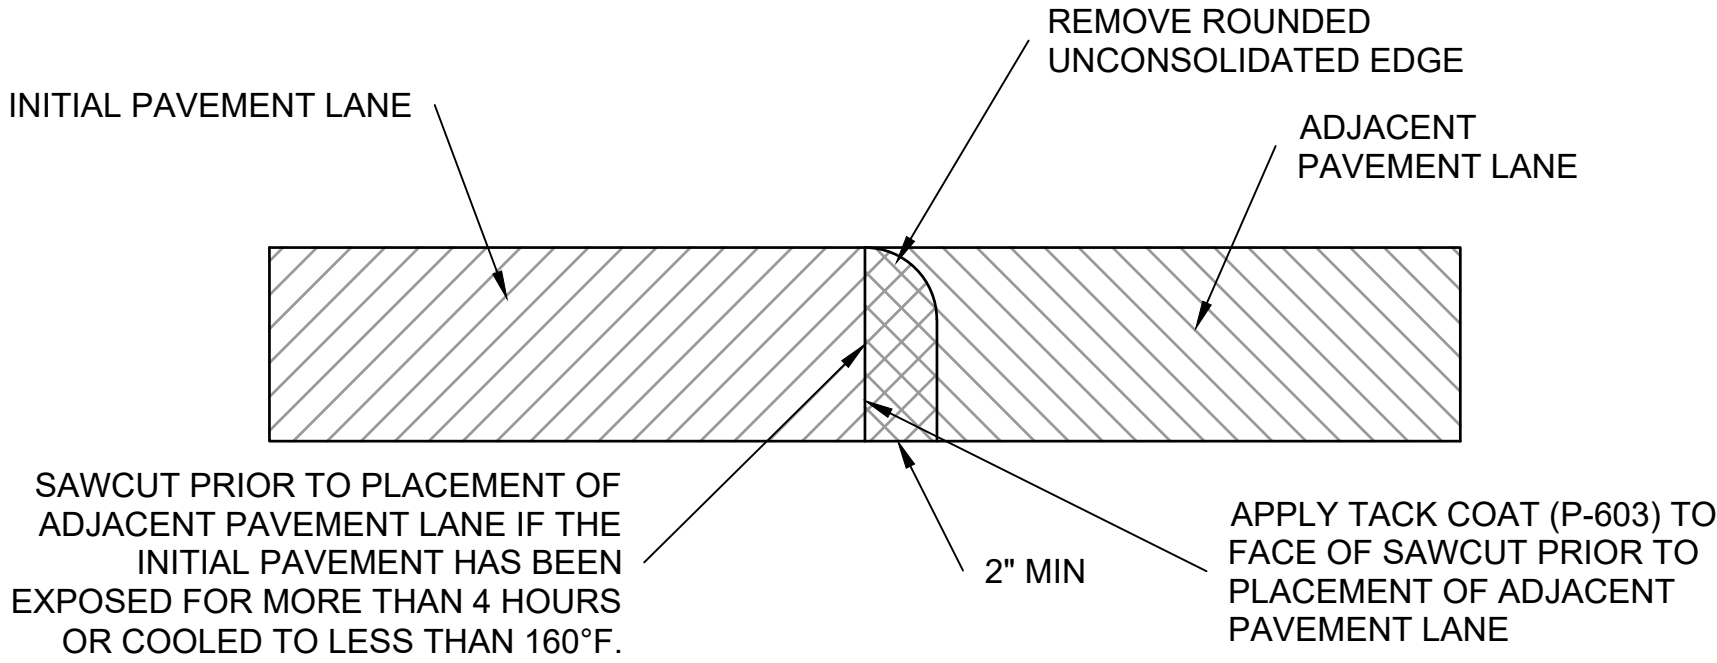

3  
CP-005  
**ASPHALT LONGITUDINAL CONSTRUCTION JOINT DETAIL**  
SCALE: NONE

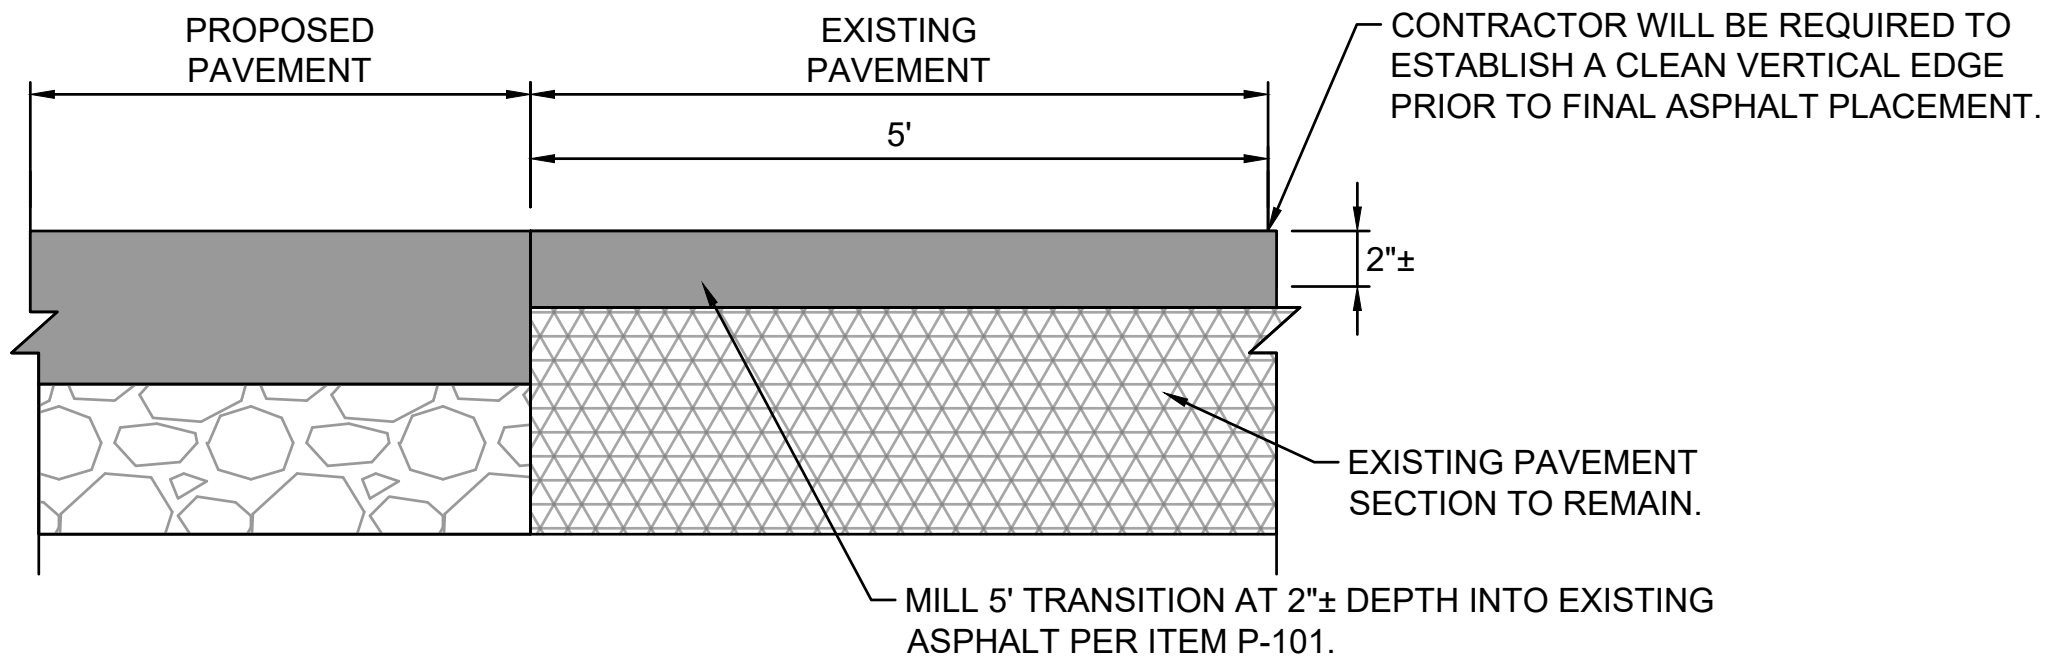

4  
CP-005  
**PROPOSED PAVEMENT TIE-IN DETAIL**  
SCALE: NONE

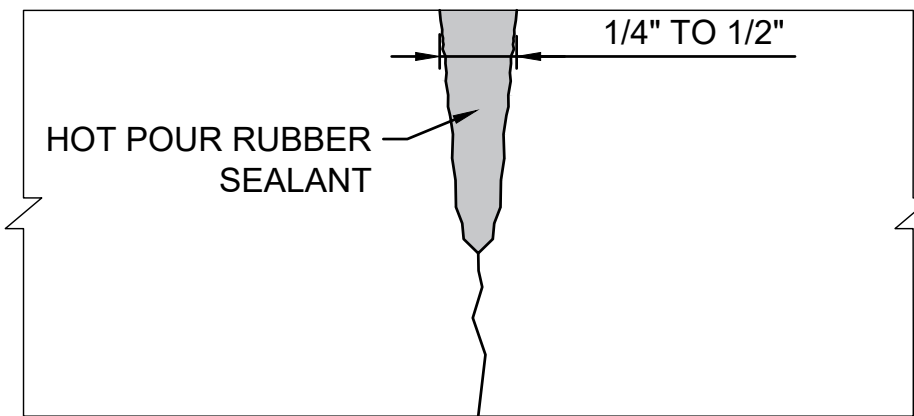

5  
CP-005  
**LOW SEVERITY CRACK REPAIR DETAIL (1/4" TO 1/2")**  
SCALE: NONE

**NOTES:**

- THOROUGHLY CLEAN AND BLOW OUT CRACK TO SOUND MATERIAL.
- HOT LANCE CRACK.
- FILL WITH HOT POUR RUBBER SEALANT.
- OVERBAND IS NOT ALLOWED.
- SPILLAGE OR OVER FILLING CRACKS AND JOINTS SHALL BE IMMEDIATELY CLEANED/REMOVED TO THE SATISFACTION OF THE ENGINEER OR THE CRACK OR JOINT SEAL SHALL BE REMOVED AND REDONE.



© 2023 GARVER, LLC  
THIS DOCUMENT, ALONG WITH THE IDEAS AND DESIGNS CONVEYED HEREIN, SHALL BE CONSIDERED INSTRUMENTS OF PROFESSIONAL SERVICE AND ARE PROPERTY OF GARVER, LLC. ANY USE, REPRODUCTION, OR DISTRIBUTION OF THIS DOCUMENT, ALONG WITH THE IDEAS AND DESIGN CONTAINED HEREIN, IS PROHIBITED UNLESS AUTHORIZED IN WRITING BY GARVER, LLC OR EXPLICITLY ALLOWED IN THE GOVERNING PROFESSIONAL SERVICES AGREEMENT FOR THIS WORK.

REV.	DATE	DESCRIPTION	BY
1	6/6/23	ADDENDUM NO. 2	AMJ

**E11**

ANDREWS COUNTY  
AIRPORT  
ANDREWS, TEXAS

RUNWAY 16 AND TAXIWAY A  
RECONSTRUCTION

MISCELLANEOUS  
DETAILS

JOB NO.: 22A11972  
DATE: JAN 2023  
DESIGNED BY: JAH  
DRAWN BY: JAH

BAR IS ONE INCH ON  
ORIGINAL DRAWING  
0 1"  
IF NOT ONE INCH ON THIS SHEET,  
ADJUST SCALES ACCORDINGLY.


DRAWING NUMBER  
**CP-005**

SHEET  
NUMBER **28**



File: L:\2022\22A11972 - E11 RW 16-34 and TW A Recon\Drawings\E11\_RW\_RHB-CP-201.dwg, Last Save: 6/6/2023 9:40 AM, Last saved by: JAHenderson  
Last plotted by: Henderson, James, A Plot Style: AECmono.ctb Plot Scale: 1:1 Plot Date: 6/6/2023 1:43 PM Plotter used: AutoCAD PDF (General Documentation).pc3

MATCHLINE STA 204+00.00 SHEET CP-201

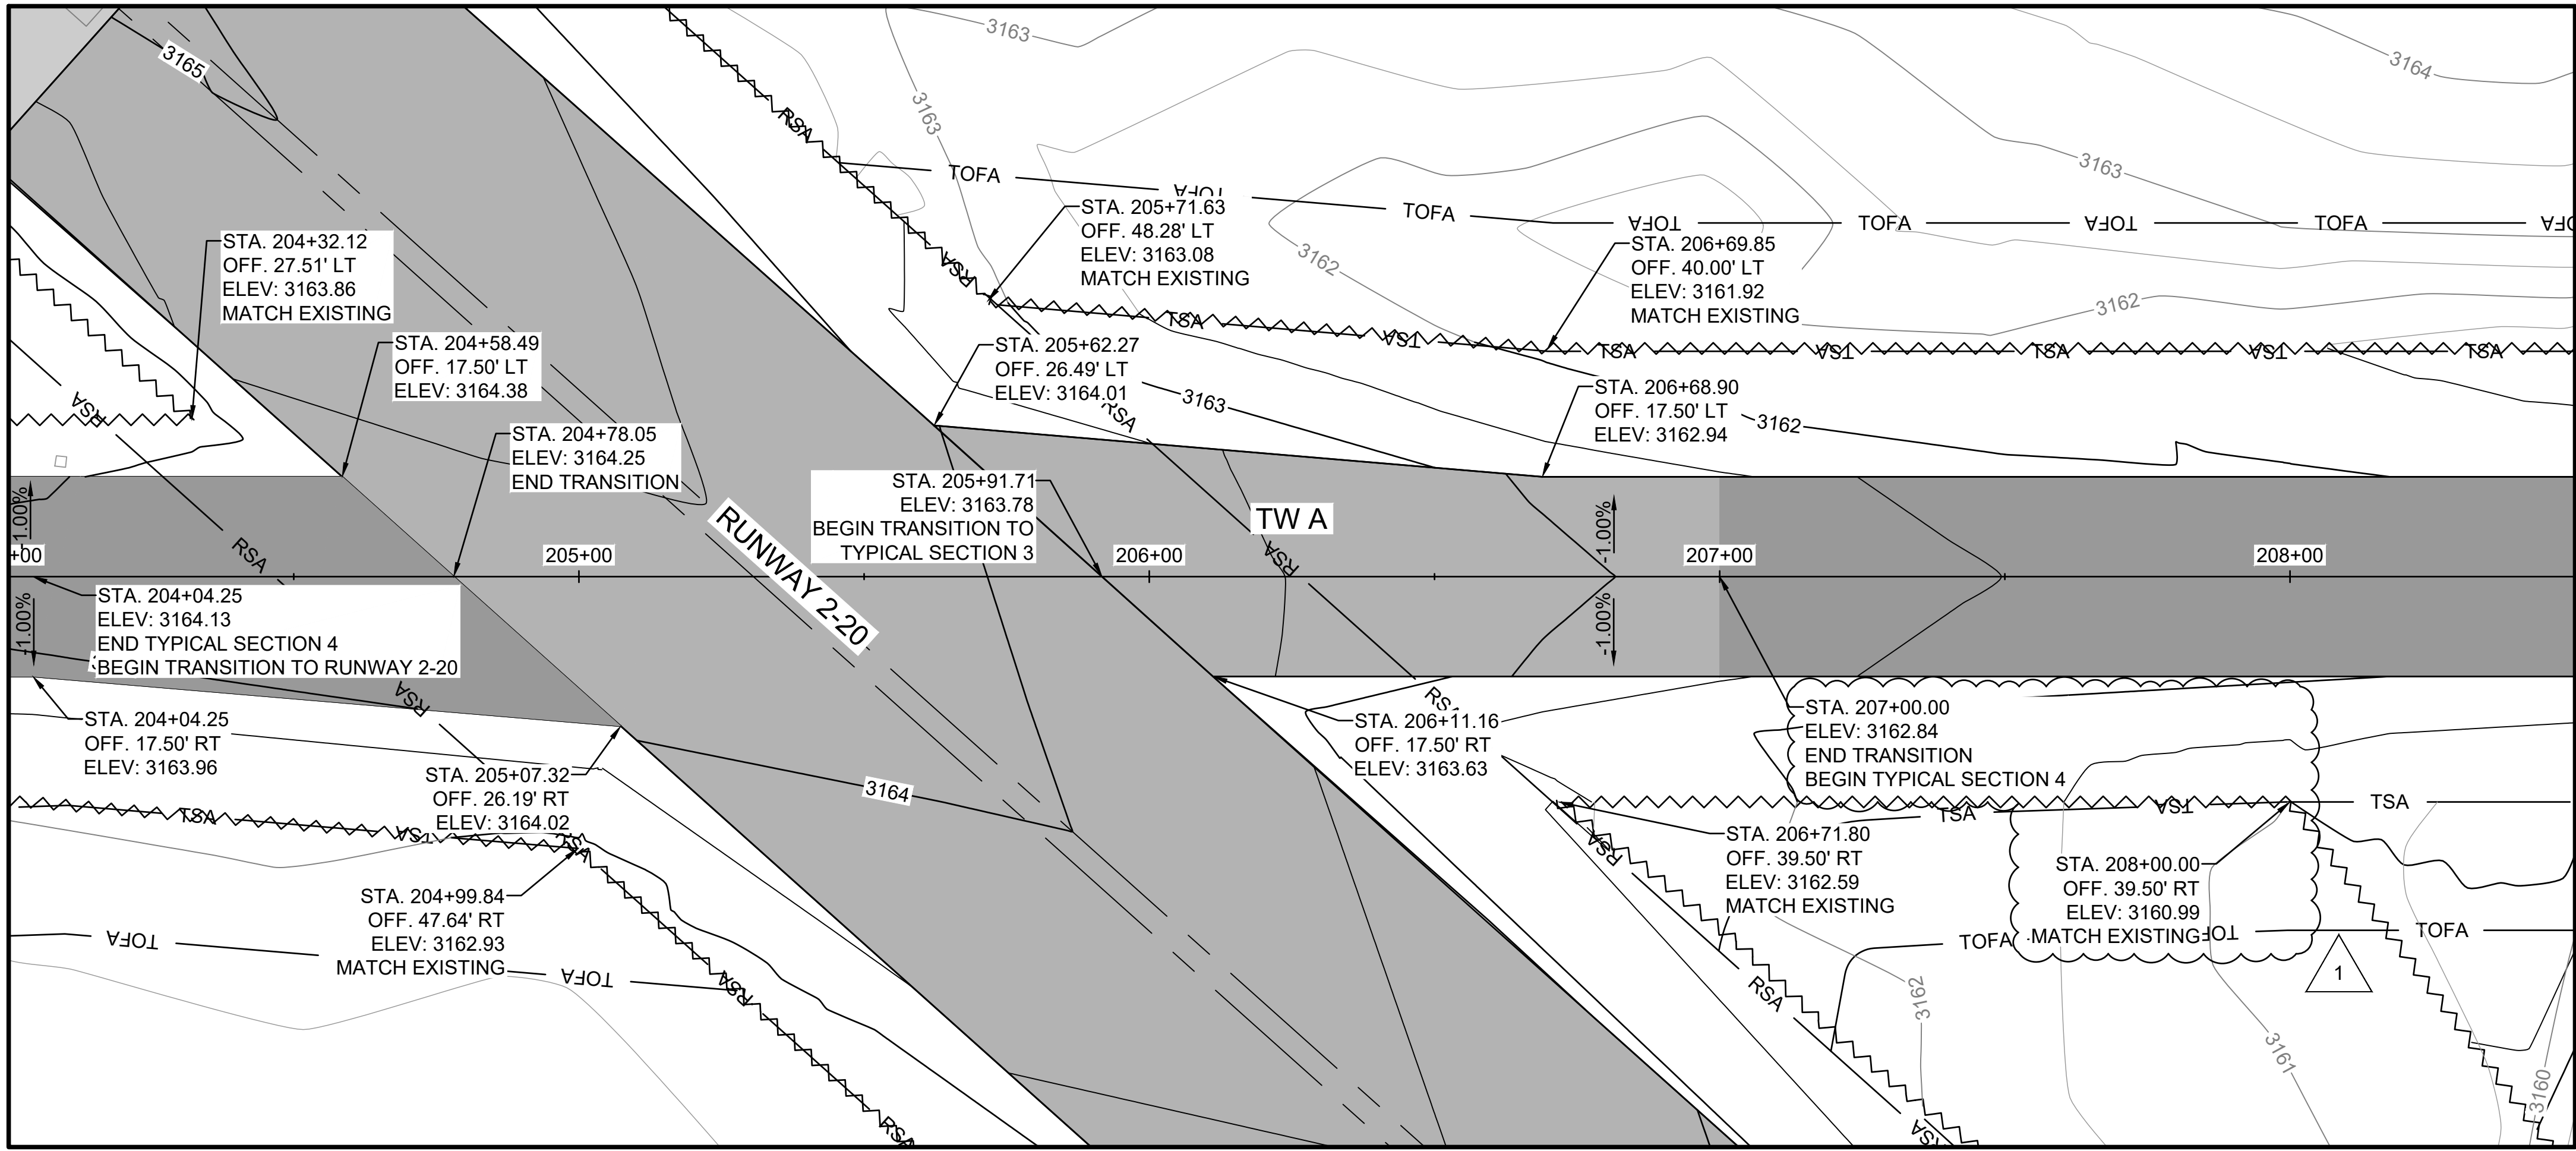


MATCHLINE STA 208+50.00 SHEET CP-203

### LEGEND

- EXISTING ASPHALT PAVEMENT
- PROPOSED FULL DEPTH RECONSTRUCTION ASPHALT PAVEMENT
- PROPOSED NEW CONSTRUCTION ASPHALT PAVEMENT
- PROPOSED GRADING LIMITS
- RSA RUNWAY SAFETY AREA
- TSA TAXIWAY SAFETY AREA
- TOFA TAXIWAY OBJECT FREE AREA
- XXXX EXISTING CONTOUR
- XXXX PROPOSED CONTOUR

- NOTES:
- PROFILE VERTICAL EXAGGERATION = 5.
  - SEE SHEETS CP-001 - CP-004 FOR TYPICAL SECTIONS.
  - SEE SHEETS XS-101 - XS-901 FOR CROSS SECTIONS
  - CONTRACTOR SHALL SAWCUT A CLEAN VERTICAL EDGE AT ALL PAVEMENT TIE-INS.
  - CONTRACTOR SHALL PROTECT ALL EXISTING UTILITIES, HAND HOLES, AIRFIELD EQUIPMENT, DRAINAGE STRUCTURES, AND BUILDINGS NOT SHOWN FOR DEMOLITION. ANY DAMAGE AS A RESULT OF CONSTRUCTION ACTIVITIES SHALL BE REPAIRED BY THE CONTRACTOR AT NO COST TO THE OWNER.

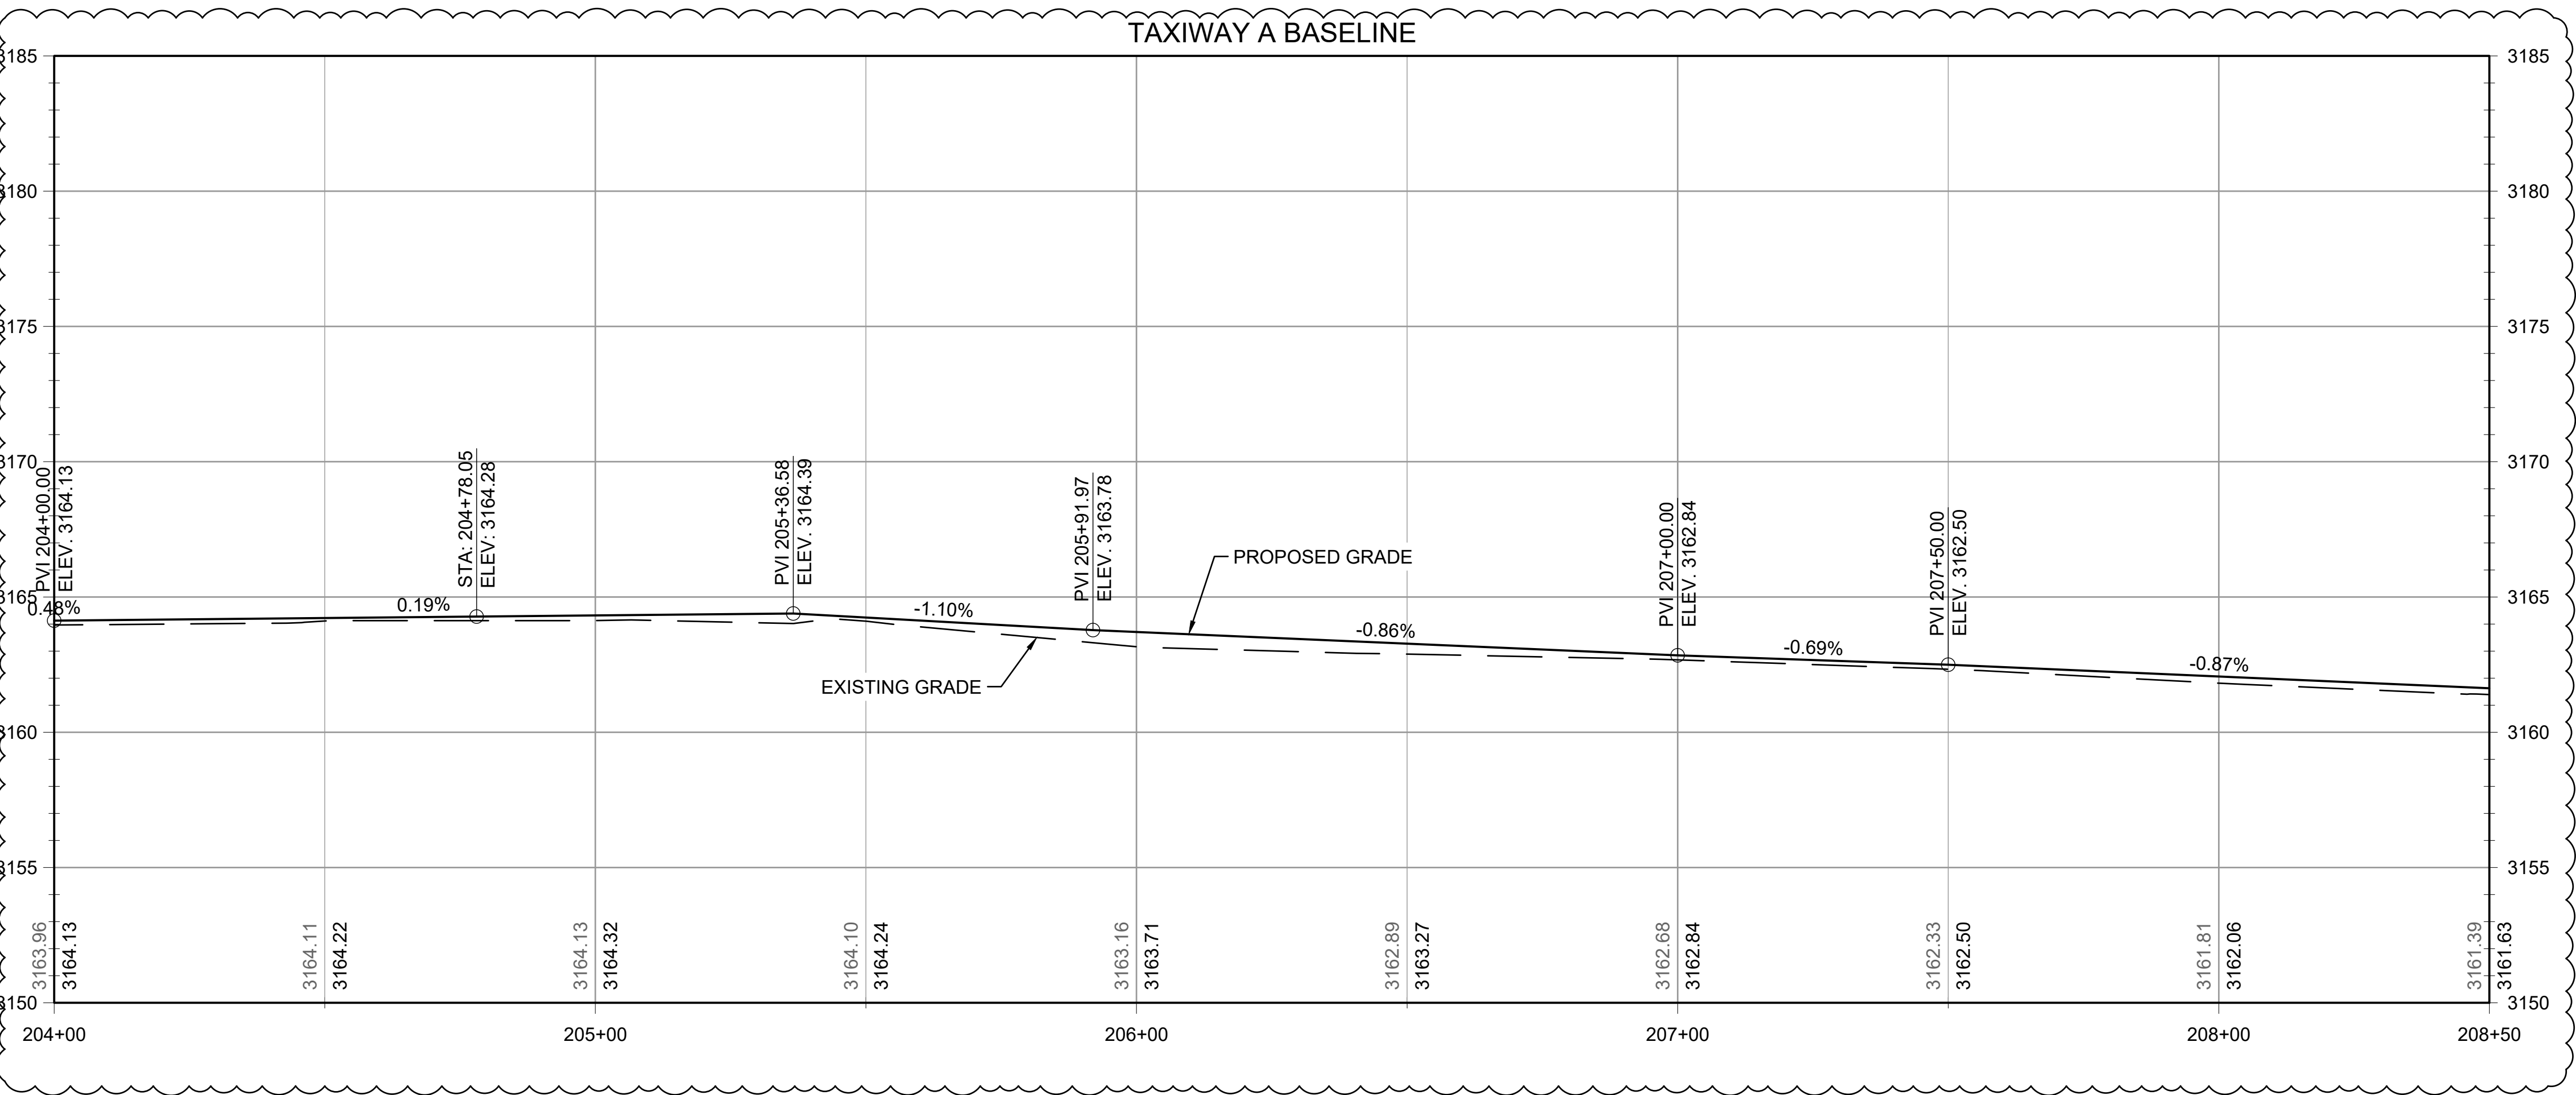

### KEYMAP

© 2023 GARVER, LLC  
THIS DOCUMENT, ALONG WITH THE IDEAS AND DESIGNS CONVEYED HEREIN, SHALL BE CONSIDERED INSTRUMENTS OF PROFESSIONAL SERVICE AND ARE PROPERTY OF GARVER, LLC. ANY USE, REPRODUCTION, OR DISTRIBUTION OF THIS DOCUMENT, ALONG WITH THE IDEAS AND DESIGN CONTAINED HEREIN, IS PROHIBITED UNLESS AUTHORIZED IN WRITING BY GARVER, LLC OR EXPLICITLY ALLOWED IN THE GOVERNING PROFESSIONAL SERVICES AGREEMENT FOR THIS WORK.

BY	AMJ		
DESCRIPTION	ADDENDUM NO. 2		
DATE	6/6/23		
REV.	1		

ANDREWS COUNTY  
AIRPORT  
ANDREWS, TEXAS

RUNWAY 16 AND TAXIWAY A  
RECONSTRUCTION

TAXIWAY A PLAN AND  
PROFILE 2

JOB NO.: 22A11972  
DATE: JAN 2023  
DESIGNED BY: JAH  
DRAWN BY: JAH

BAR IS ONE INCH ON  
ORIGINAL DRAWING  
0 1"  
IF NOT ONE INCH ON THIS SHEET,  
ADJUST SCALES ACCORDINGLY.


DRAWING NUMBER  
**CP-202**

SHEET  
NUMBER **46**




File: L:\2022\22A11972 - E11 RW 16-34 and TW A Recon\Drawings\E11\_RW\_RHB-CP-201.dwg, Last Save: 6/6/2023 9:40 AM, Last saved by: JAHenderson  
Last plotted by: Henderson, James, A Plot Style: AECmono.ctb Plot Scale: 1:1 Plot Date: 6/6/2023 1:43 PM Plotter used: AutoCAD PDF (General Documentation).pc3

MATCHLINE STA 208+50.00 SHEET CP-202

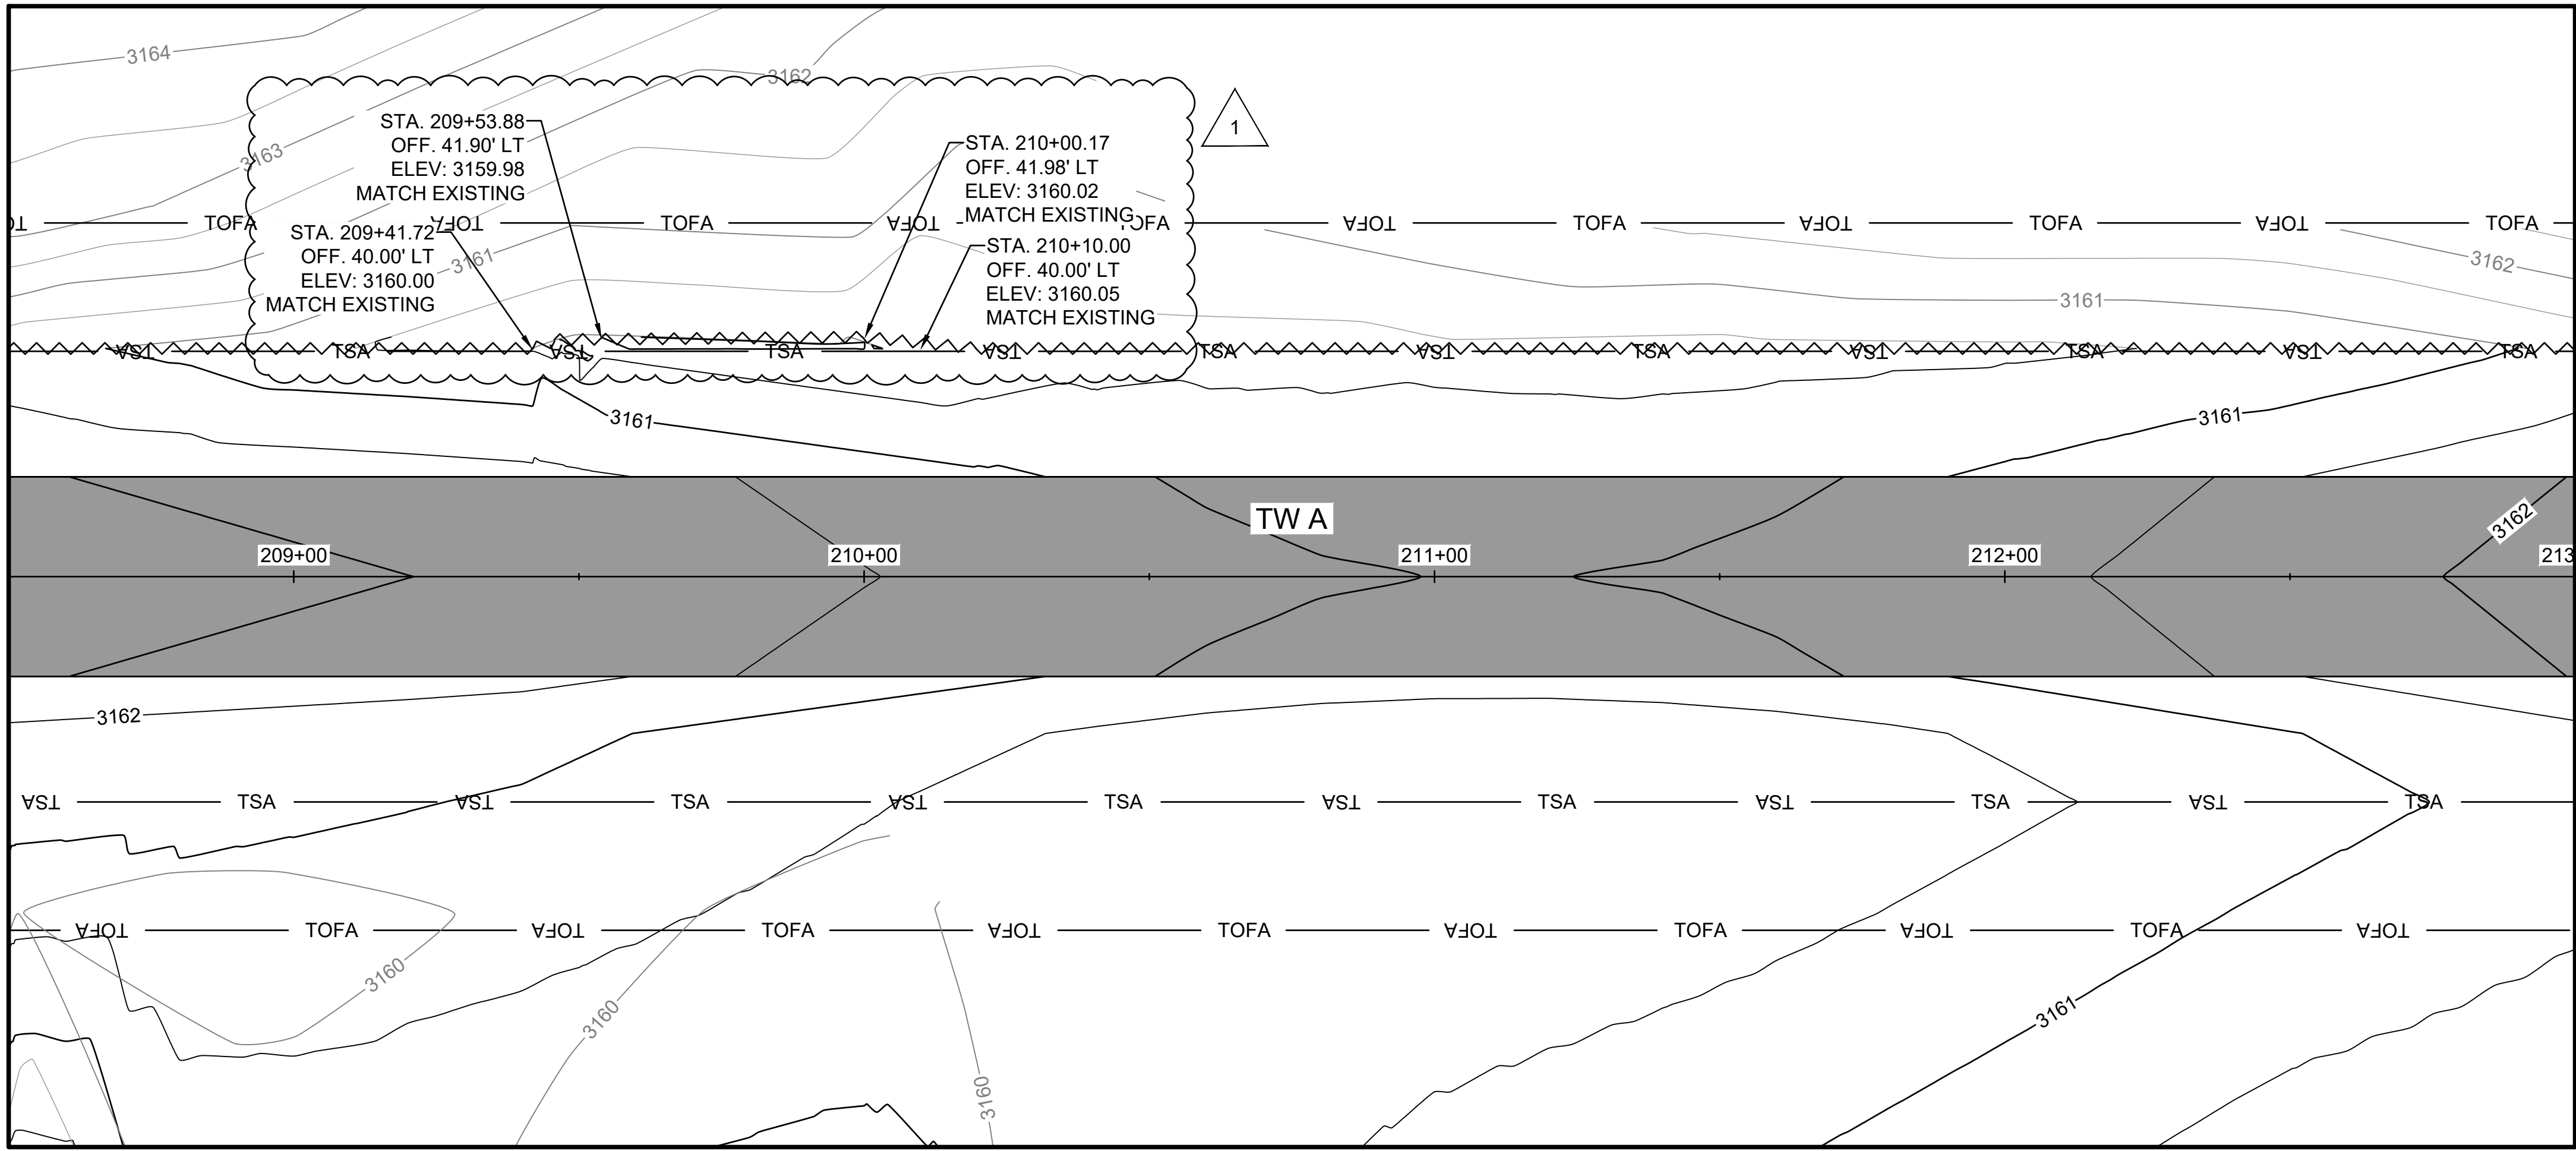

MATCHLINE STA 213+00.00 SHEET CP-204

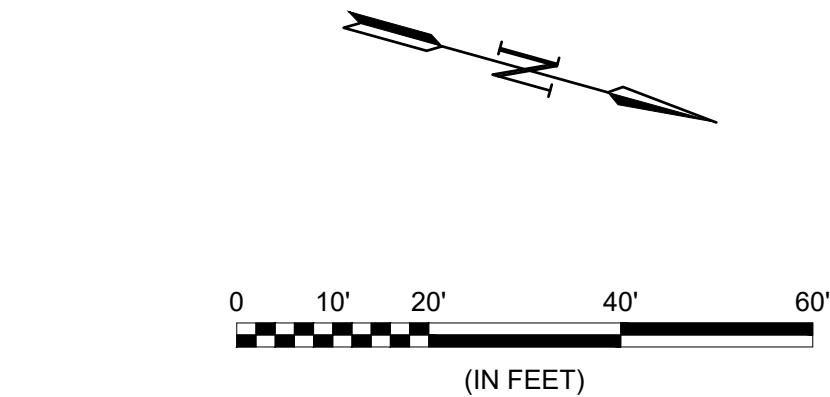


### LEGEND

- PROPOSED FULL DEPTH RECONSTRUCTION ASPHALT PAVEMENT
- PROPOSED GRADING LIMITS
- TSA TAXIWAY SAFETY AREA
- TOFA TAXIWAY OBJECT FREE AREA
- XXXX EXISTING CONTOUR
- XXXX PROPOSED CONTOUR

#### NOTES:

- PROFILE VERTICAL EXAGGERATION = 5.
- SEE SHEETS CP-001 - CP-004 FOR TYPICAL SECTIONS.
- SEE SHEETS XS-101 - XS-901 FOR CROSS SECTIONS
- CONTRACTOR SHALL SAWCUT A CLEAN VERTICAL EDGE AT ALL PAVEMENT TIE-INS.
- CONTRACTOR SHALL PROTECT ALL EXISTING UTILITIES, HAND HOLES, AIRFIELD EQUIPMENT, DRAINAGE STRUCTURES, AND BUILDINGS NOT SHOWN FOR DEMOLITION. ANY DAMAGE AS A RESULT OF CONSTRUCTION ACTIVITIES SHALL BE REPAIRED BY THE CONTRACTOR AT NO COST TO THE OWNER.

### TAXIWAY A BASELINE

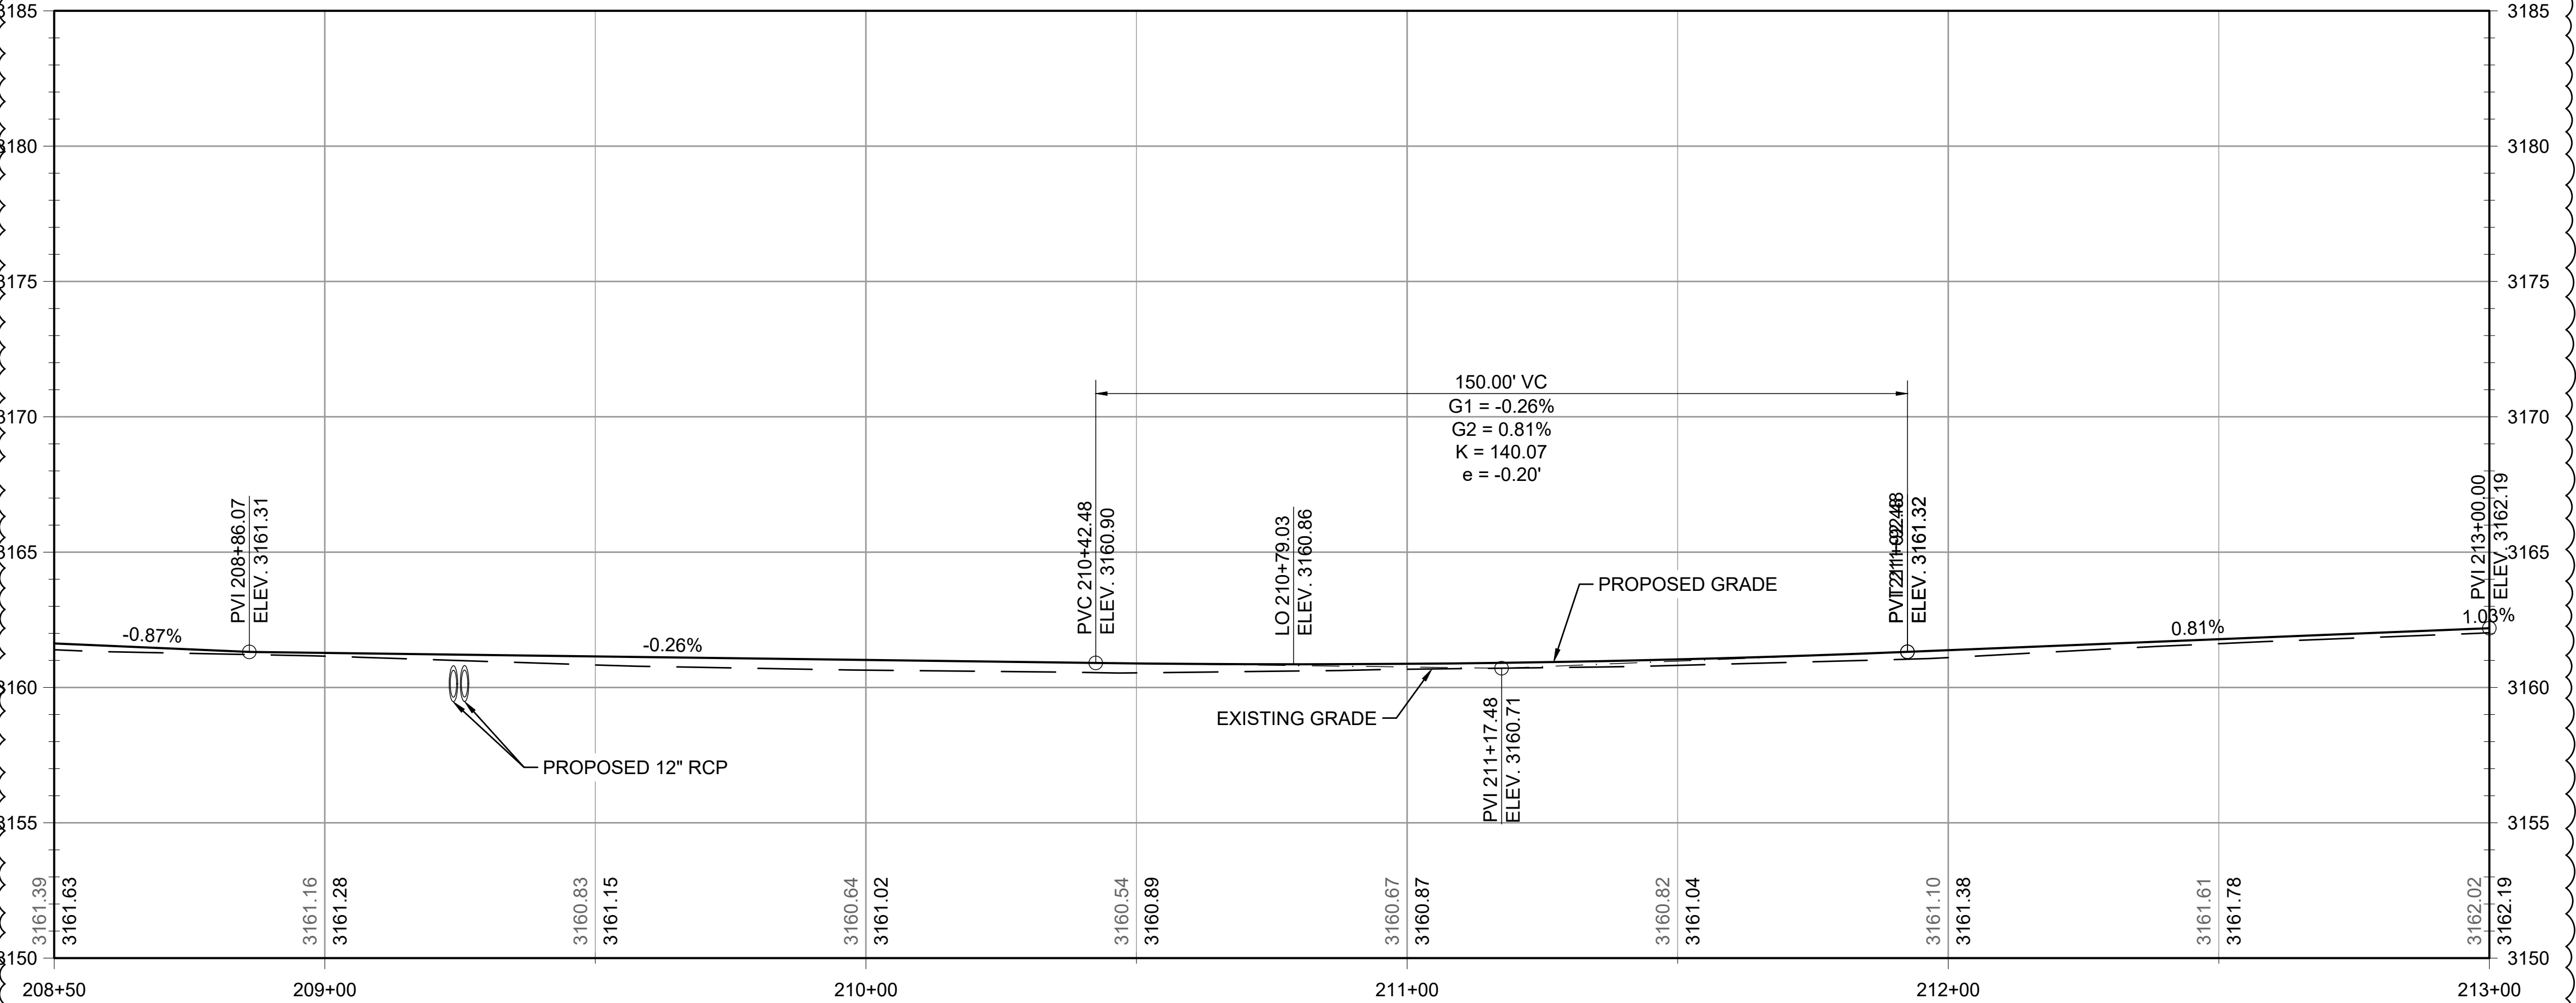

**GARVER**

© 2023 GARVER, LLC  
THIS DOCUMENT, ALONG WITH THE IDEAS AND DESIGNS CONVEYED HEREIN, SHALL BE CONSIDERED INSTRUMENTS OF PROFESSIONAL SERVICE AND ARE PROPERTY OF GARVER, LLC. ANY USE, REPRODUCTION, OR DISTRIBUTION OF THIS DOCUMENT, ALONG WITH THE IDEAS AND DESIGN CONTAINED HEREIN, IS PROHIBITED UNLESS AUTHORIZED IN WRITING BY GARVER, LLC OR EXPLICITLY ALLOWED IN THE GOVERNING PROFESSIONAL SERVICES AGREEMENT FOR THIS WORK.

REV.	DATE	DESCRIPTION	BY
1	6/6/23	ADDENDUM NO. 2	AMJ

**E11**

ANDREWS COUNTY  
AIRPORT  
ANDREWS, TEXAS

RUNWAY 16 AND TAXIWAY A  
RECONSTRUCTION

TAXIWAY A PLAN AND  
PROFILE 3

JOB NO.: 22A11972  
DATE: JAN 2023  
DESIGNED BY: JAH  
DRAWN BY: JAH



BAR IS ONE INCH ON  
ORIGINAL DRAWING  
IF NOT ONE INCH ON THIS SHEET,  
ADJUST SCALES ACCORDINGLY.

DRAWING NUMBER  
**CP-203**

SHEET  
NUMBER **47**




File: L:\2022\22A11972 - E11 RW 16-34 and TW A Recon\Drawings\E11\_RW\_RHB-CC-101.dwg Last Save: 6/6/2023 10:43 AM Last saved by: JAHenderson  
Last plotted by: Henderson, James, A Plot Style: AECmono.ctb Plot Scale: 1:1 Plot Date: 6/6/2023 1:44 PM Plotter used: AutoCAD PDF (General Documentation).pc3

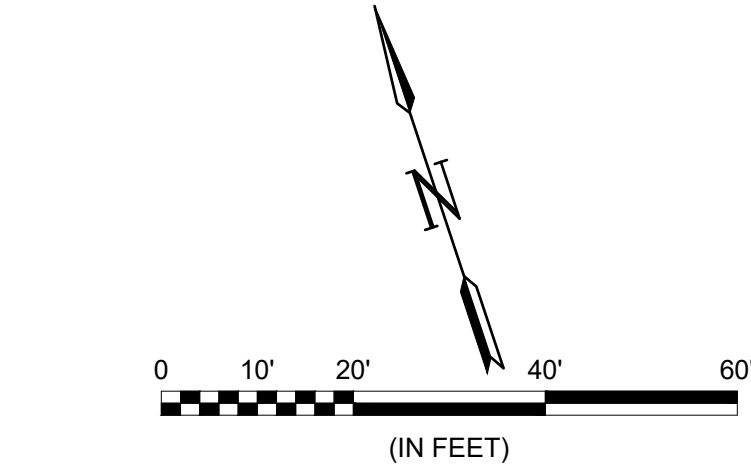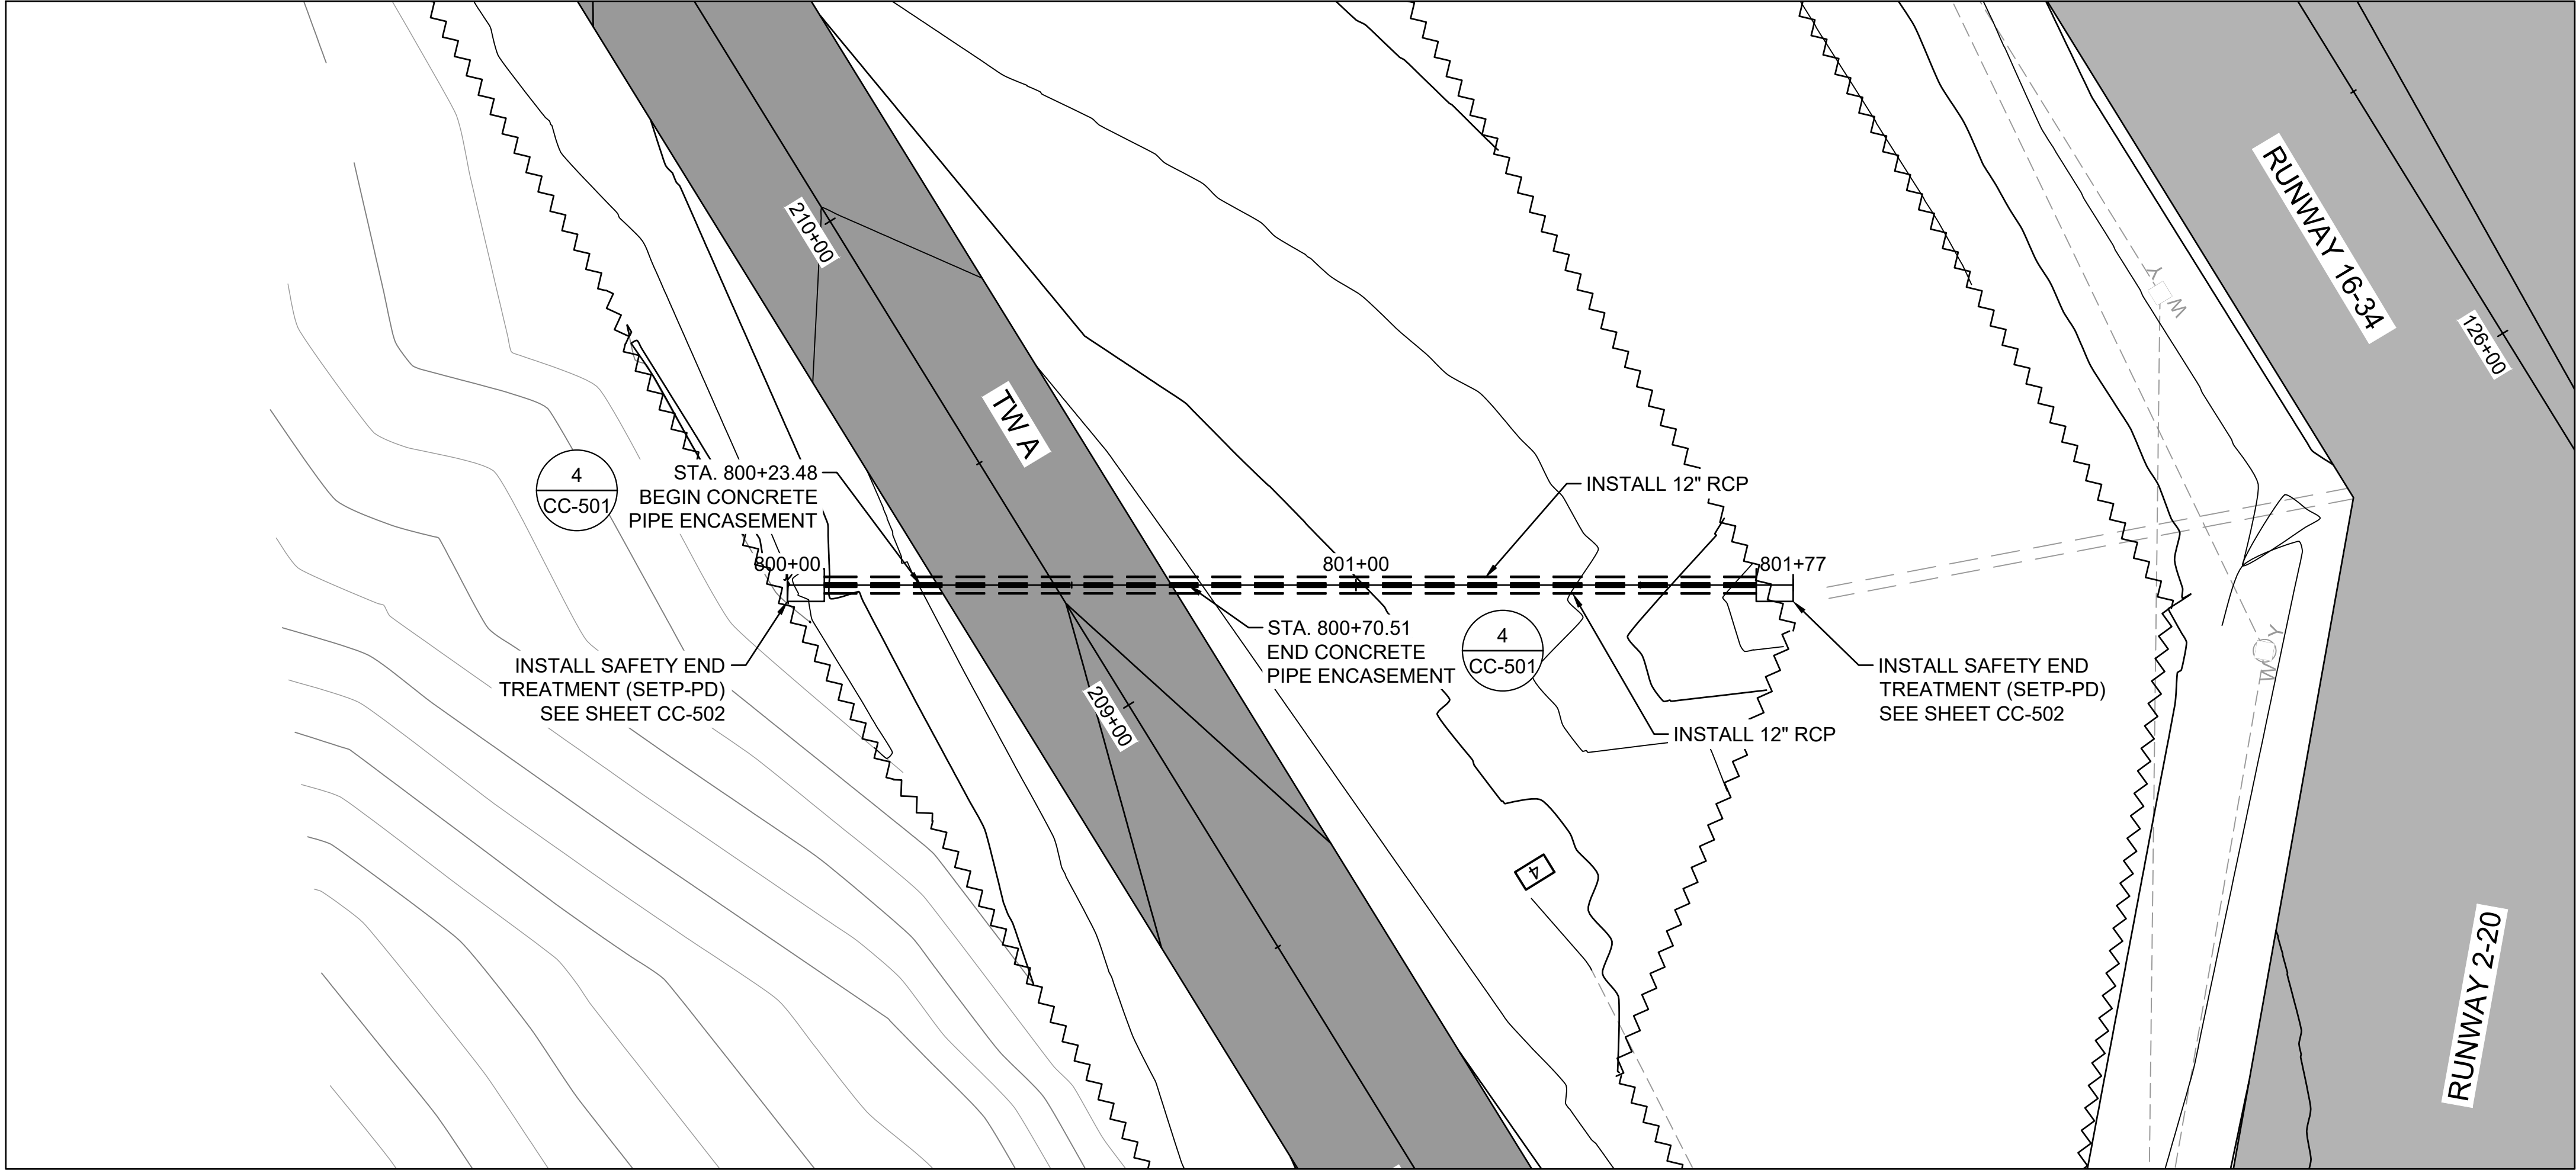

LEGEND	
	PROPOSED FULL DEPTH RECONSTRUCTION ASPHALT PAVEMENT
	PROPOSED NEW CONSTRUCTION ASPHALT PAVEMENT
	PROPOSED STORM DRAIN PIPE
	EXISTING STORM DRAIN PIPE
	PROPOSED CONTOUR
	EXISTING CONTOUR
	PROPOSED GRADING LIMITS
	PROPOSED RUNWAY LIGHT
	EXISTING RUNWAY LIGHT
	PROPOSED DUCT
	EXISTING DUCT
	PROPOSED SIGN
	STA: OFF: ELEV:
	GRADING PVI

- NOTES:
- PROFILE VERTICAL EXAGGERATION = 5
  - SEE SHEET CC-501 FOR DRAINAGE DETAILS

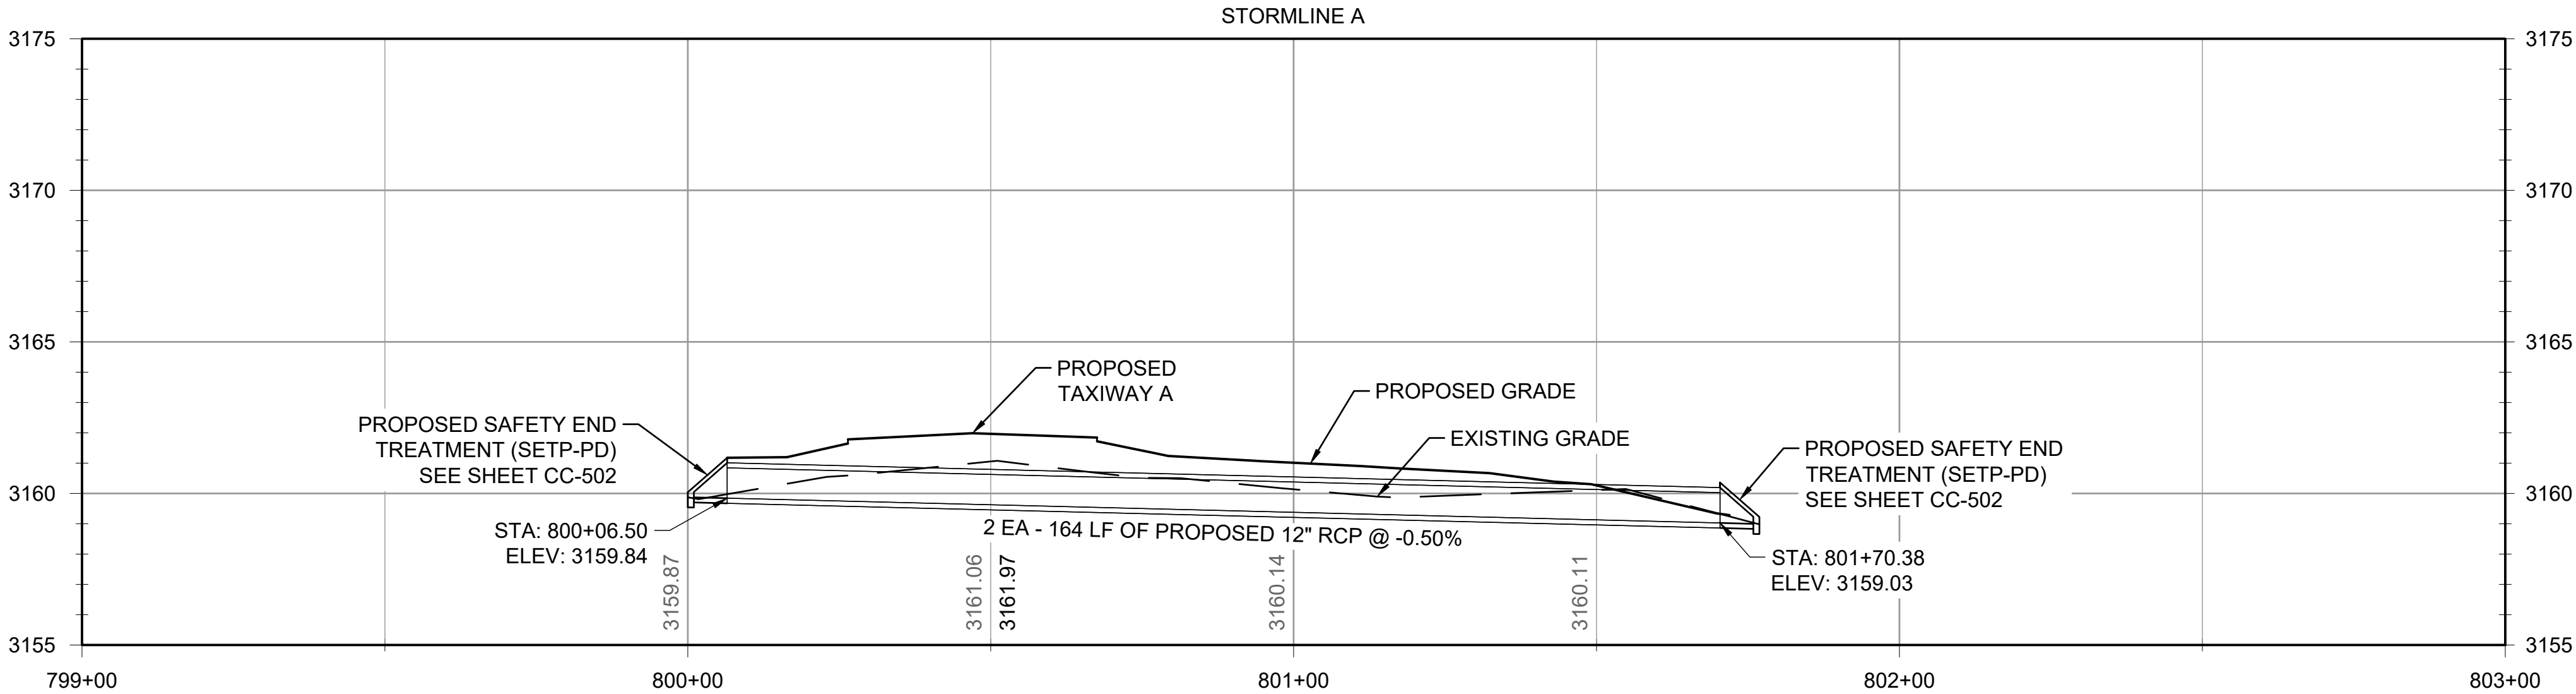

REV.	DATE	DESCRIPTION	BY
1	6/6/23	ADDENDUM NO. 2	AMJ





© 2023 GARVER, LLC  
THIS DOCUMENT, ALONG WITH THE  
IDEAS AND DESIGNS CONVEYED  
HEREIN, SHALL BE CONSIDERED  
INSTRUMENTS OF PROFESSIONAL  
SERVICE AND ARE PROPERTY OF  
GARVER, LLC. ANY USE,  
REPRODUCTION, OR DISTRIBUTION  
OF THIS DOCUMENT, ALONG WITH  
THE IDEAS AND DESIGN CONTAINED  
HEREIN, IS PROHIBITED UNLESS  
AUTHORIZED IN WRITING BY  
GARVER, LLC OR EXPLICITLY  
ALLOWED IN THE GOVERNING  
PROFESSIONAL SERVICES  
AGREEMENT FOR THIS WORK.

REV.	DATE	DESCRIPTION	BY
1	6/8/23	ADDENDUM NO. 2	AMJ



ANDREWS COUNTY  
AIRPORT  
ANDREWS, TEXAS

# RUNWAY 16 AND TAXIWAY A RECONSTRUCTION

STORM DETAILS 1

JOB NO.: 22A11972  
DATE: JAN 2023  
DESIGNED BY: JAH  
DRAWN BY: JAH

BAR IS ONE INCH ON  
ORIGINAL DRAWING

0 1"

DRAWING NUMBER

**CC-501**




SHEET NUMBER **73**








File: L:\2022\22A11972 - E11 RW 16-34 and TW A Recon\Drawings\REF1E11\_RW16-CAF-XSEC-TWA-20SCALE.dwg, Last Saved: 6/6/2023 9:49 AM, Last saved by: JAHenderson  
Last plotted by: Henderson, James, A Plot Style: AECmono.ctb Plot Scale: 1:1 Plot Date: 6/6/2023 1:44 PM Plotter used: AutoCAD PDF (General Documentation).pc3

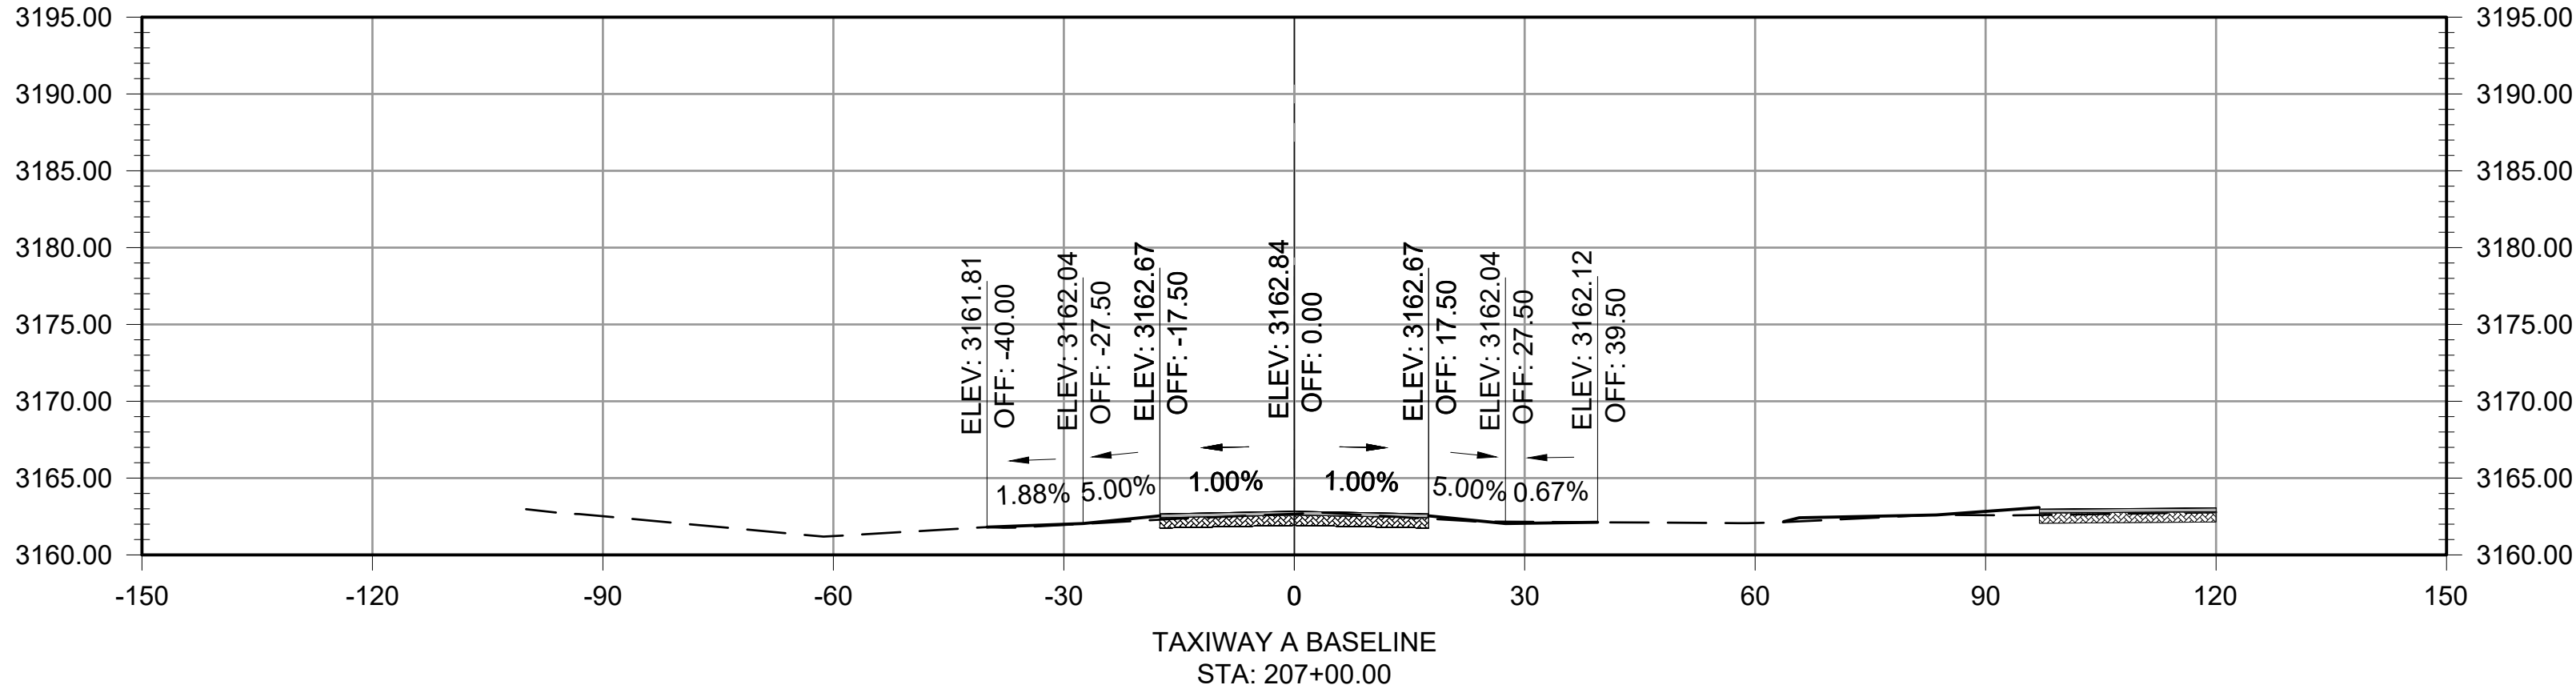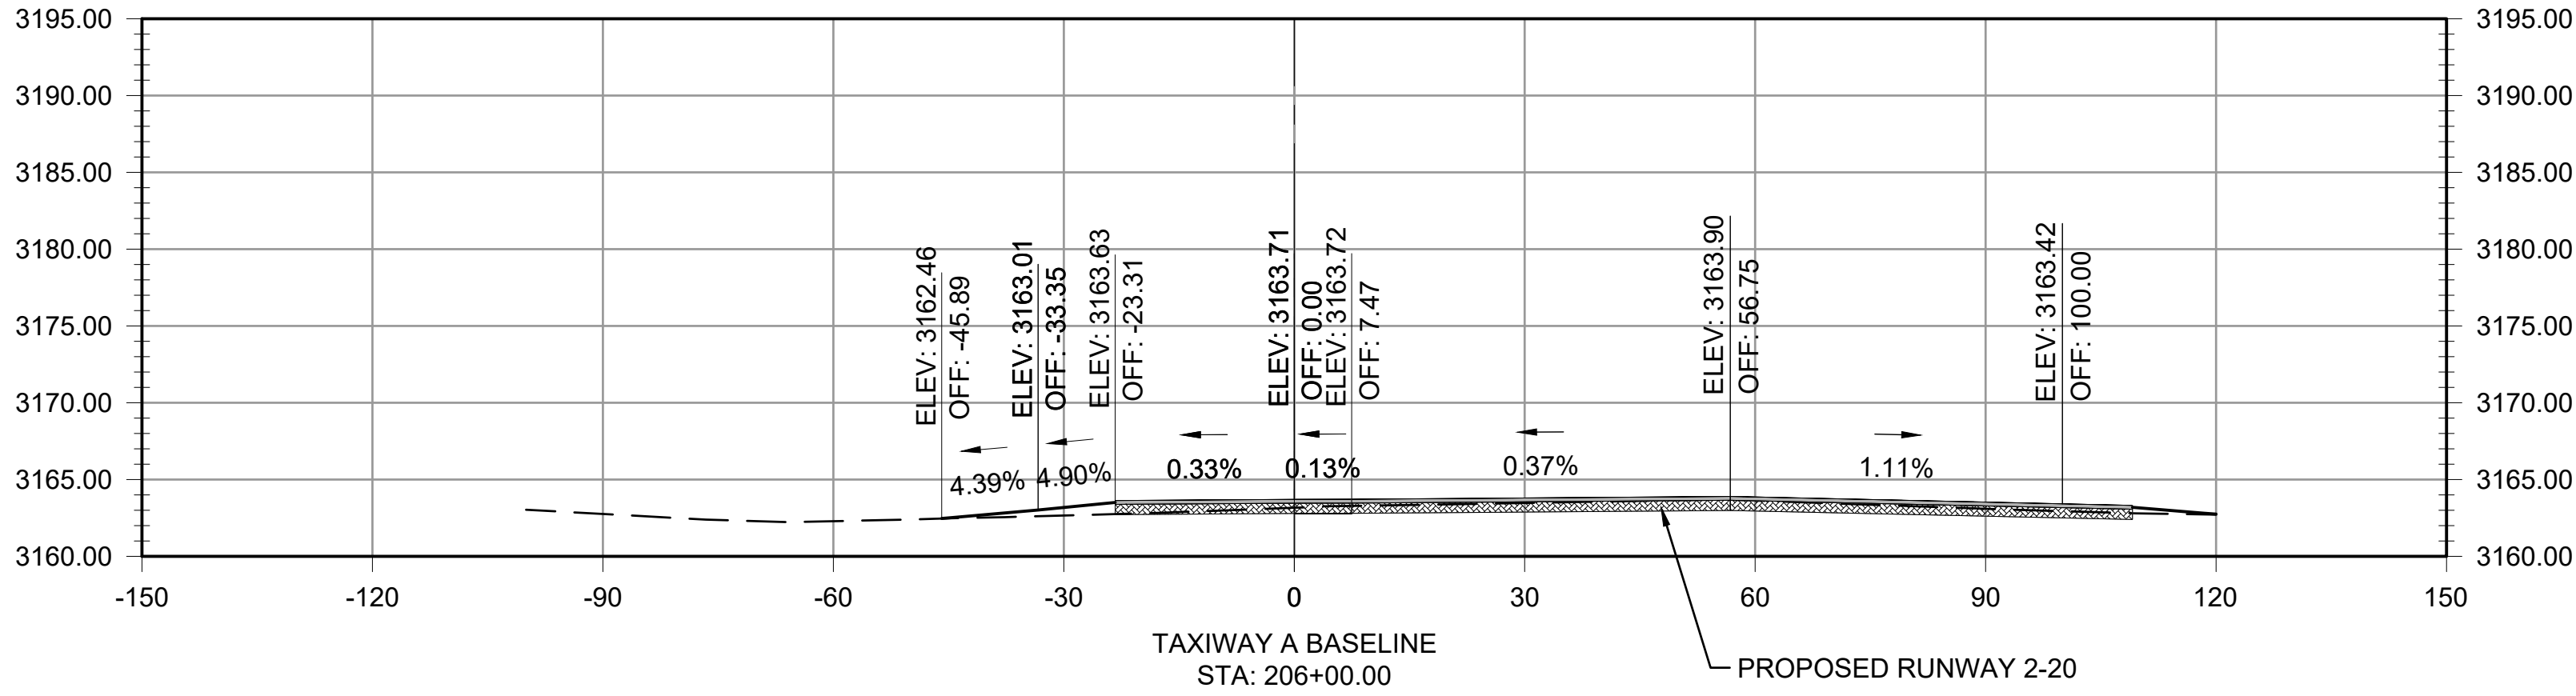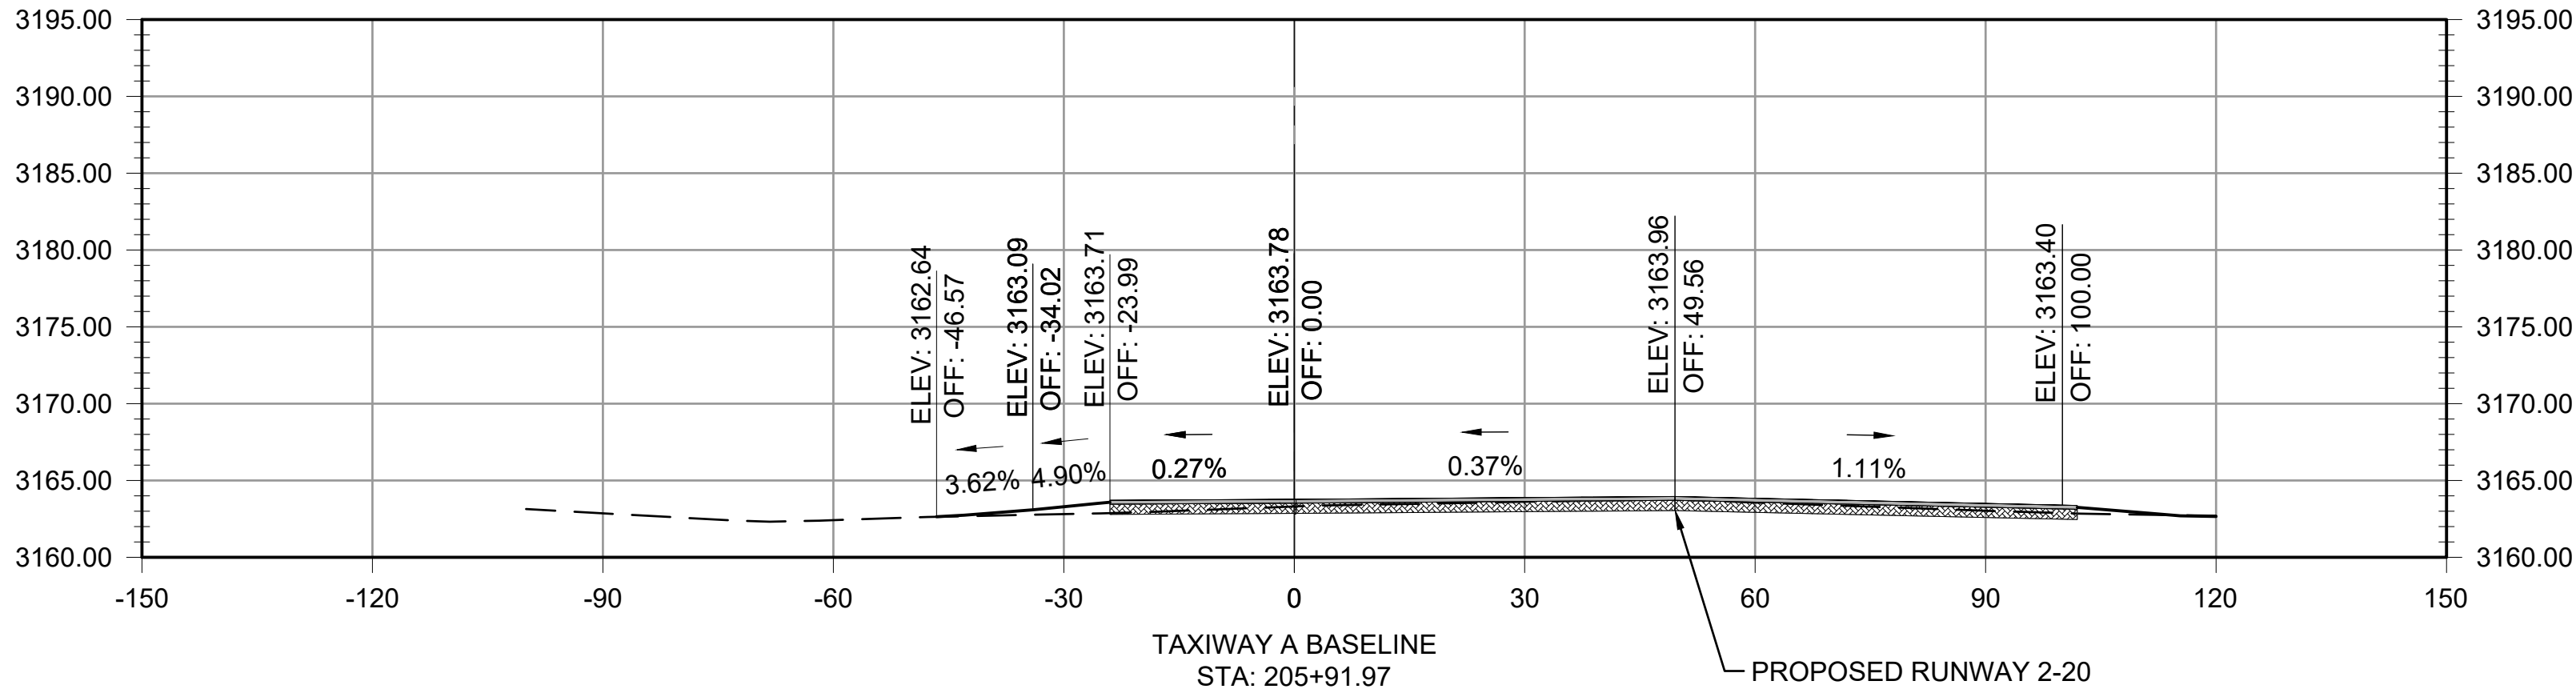

1

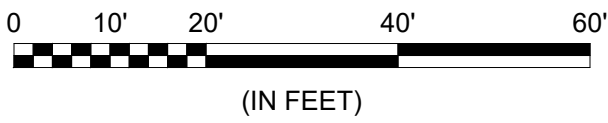

VERTICAL EXAGGERATION = 2



© 2023 GARVER, LLC  
THIS DOCUMENT, ALONG WITH THE  
IDEAS AND DESIGNS CONVEYED  
HEREIN, SHALL BE CONSIDERED  
INSTRUMENTS OF PROFESSIONAL  
SERVICE AND ARE PROPERTY OF  
GARVER, LLC. ANY USE,  
REPRODUCTION, OR DISTRIBUTION  
OF THIS DOCUMENT, ALONG WITH  
THE IDEAS AND DESIGN CONTAINED  
HEREIN, IS PROHIBITED UNLESS  
AUTHORIZED IN WRITING BY  
GARVER, LLC OR EXPLICITLY  
ALLOWED IN THE GOVERNING  
PROFESSIONAL SERVICES  
AGREEMENT FOR THIS WORK.

REV.	DATE	DESCRIPTION	BY
1	6/6/23	ADDENDUM NO. 2	AMJ



ANDREWS COUNTY  
AIRPORT  
ANDREWS, TEXAS

RUNWAY 16 AND TAXIWAY A  
RECONSTRUCTION

TAXIWAY A CROSS  
SECTIONS 2


JOB NO.: 22A11972  
DATE: JAN 2023  
DESIGNED BY: JAH  
DRAWN BY: JAH

BAR IS ONE INCH ON  
ORIGINAL DRAWING  
IF NOT ONE INCH ON THIS SHEET,  
ADJUST SCALES ACCORDINGLY.


DRAWING NUMBER  
**XS-202**

SHEET  
NUMBER **144**

File: L:\2022\22A11972 - E11 RW 16-34 and TW A Recon\Drawings\REFIE11\_RW16-CAF-XSEC-TWA-20SCALE.dwg, Last Saved: 6/6/2023 9:49 AM, Last saved by: JAHenderson  
Last plotted by: Henderson, James, A Plot Style: AECmono.ctb Plot Scale: 1:1 Plot Date: 6/6/2023 1:44 PM Plotter used: AutoCAD PDF (General Documentation).pc3

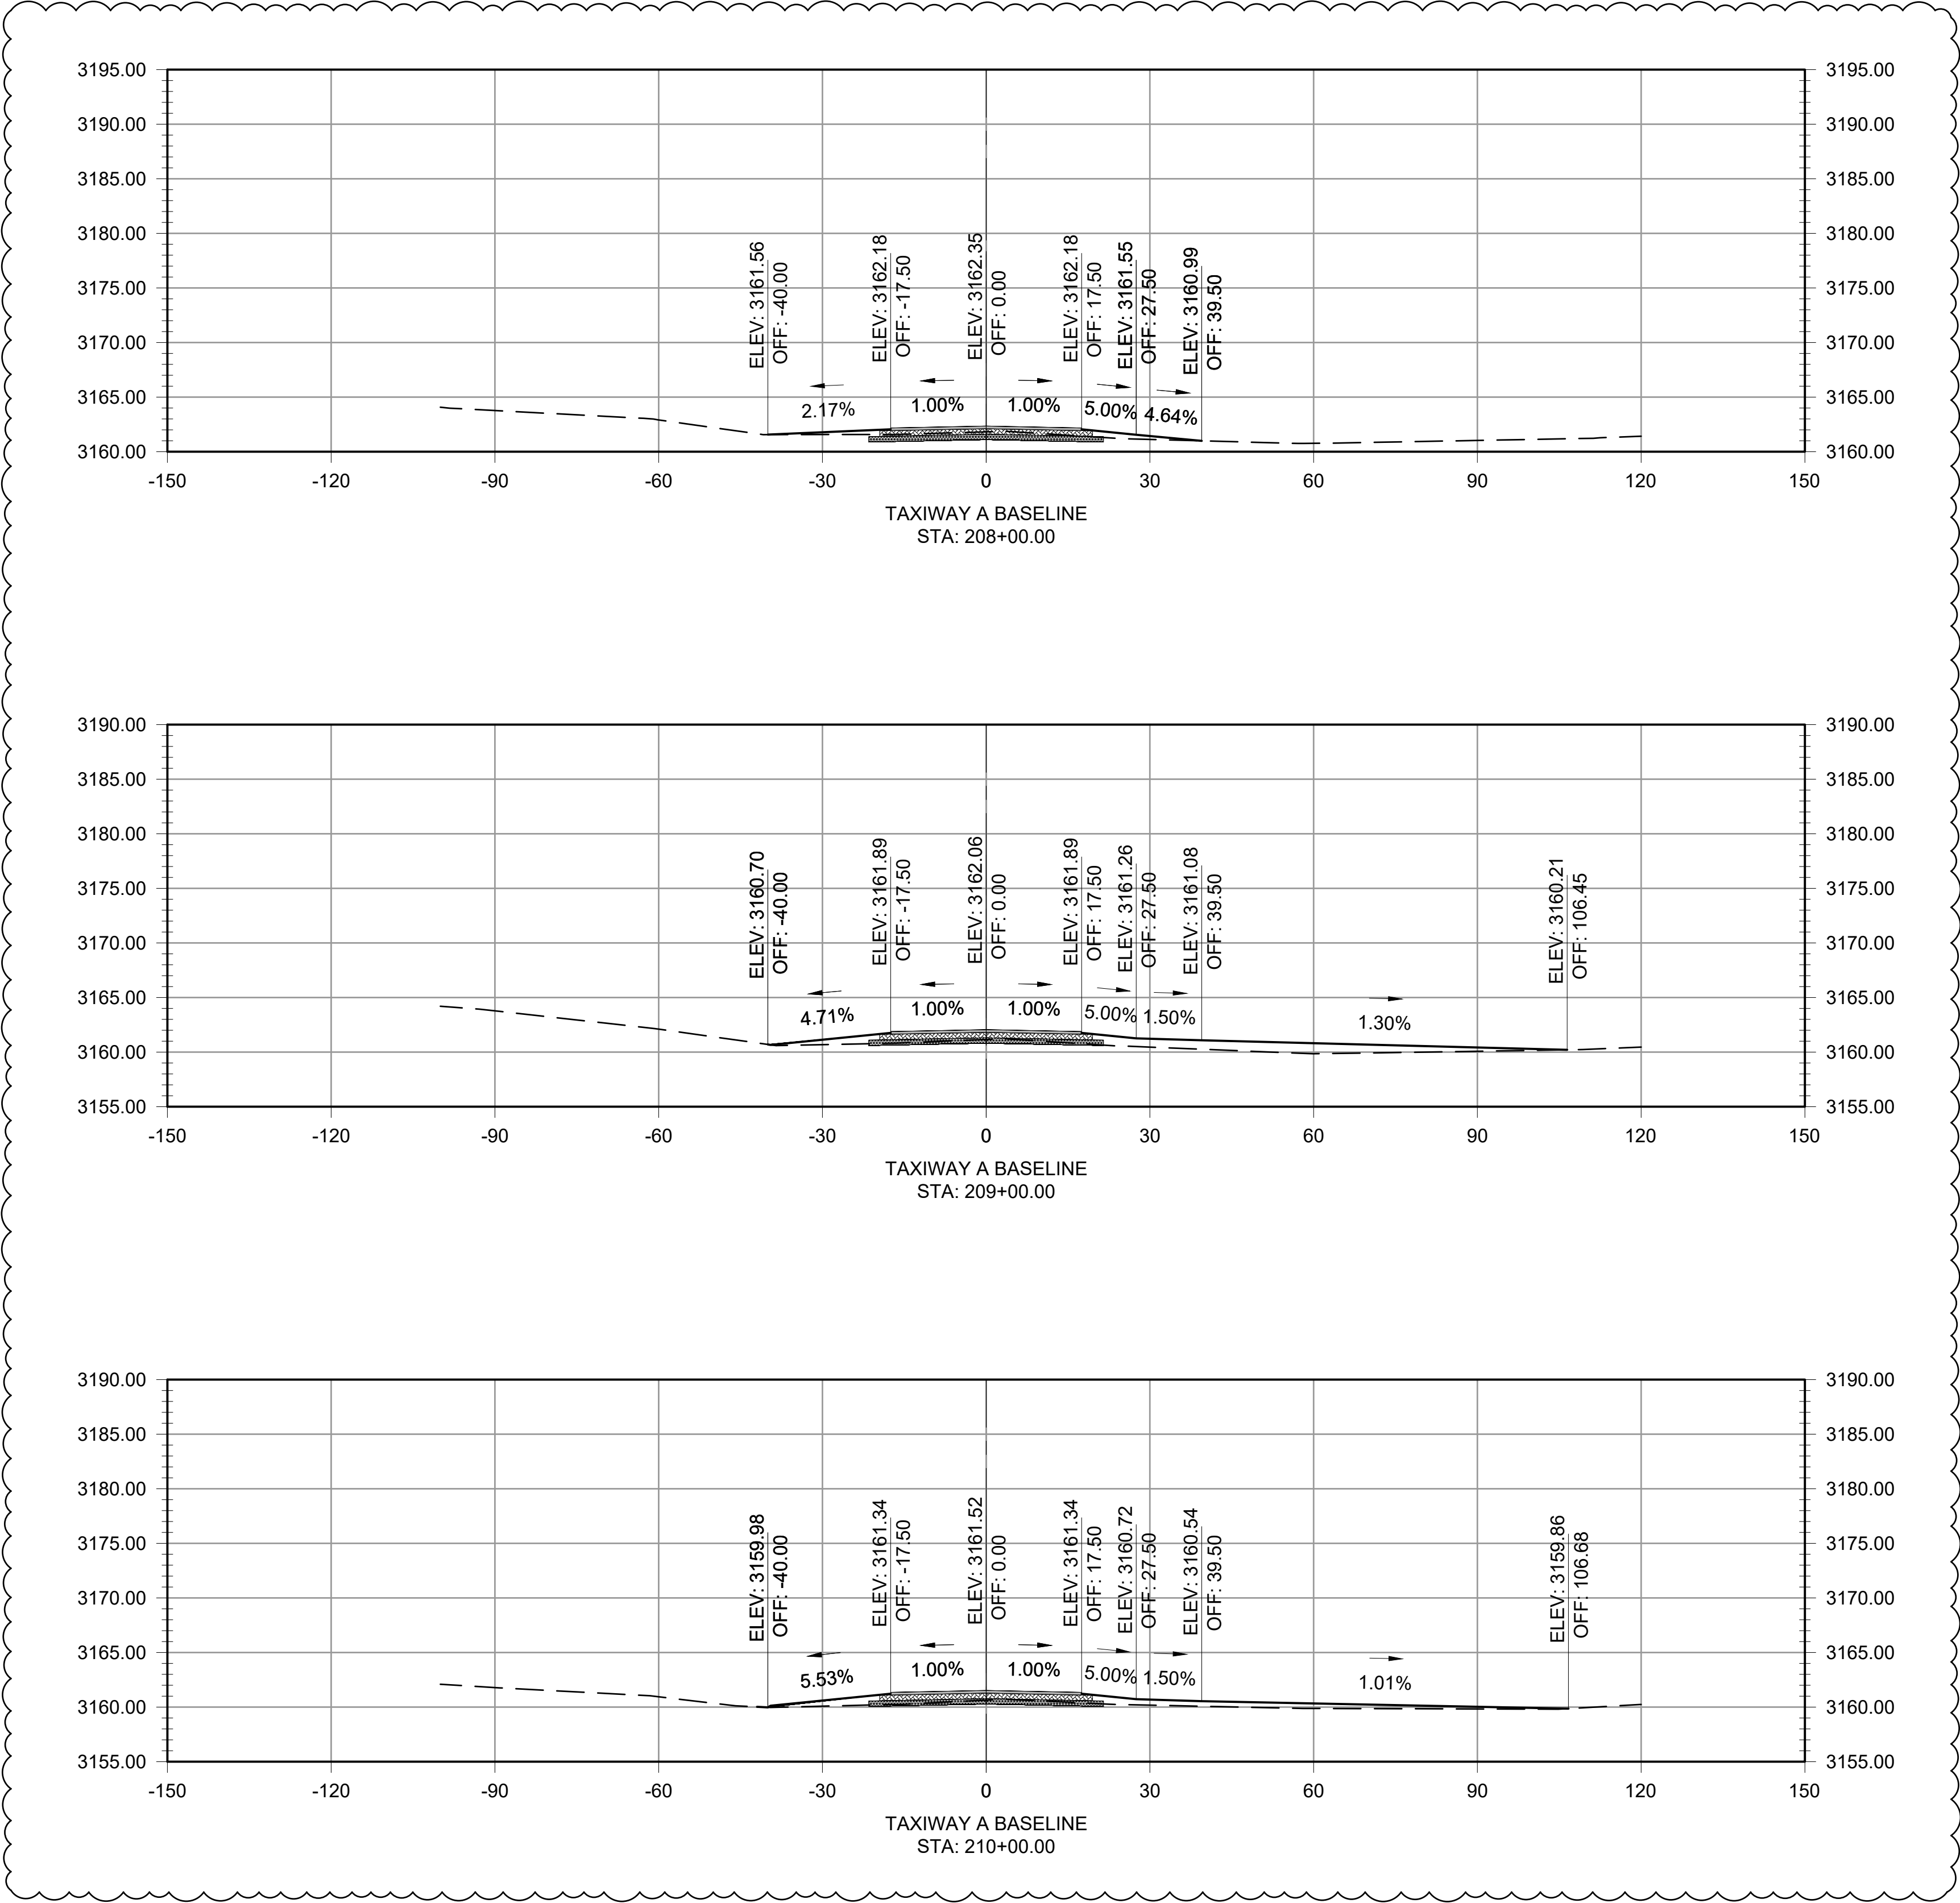

1

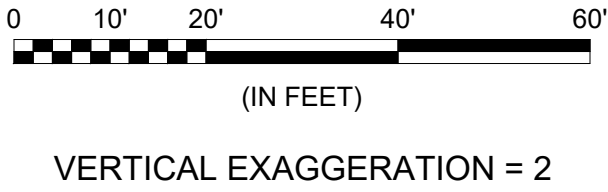


VERTICAL EXAGGERATION = 2



© 2023 GARVER, LLC  
THIS DOCUMENT, ALONG WITH THE  
IDEAS AND DESIGNS CONVEYED  
HEREIN, SHALL BE CONSIDERED  
INSTRUMENTS OF PROFESSIONAL  
SERVICE AND ARE PROPERTY OF  
GARVER, LLC. ANY USE,  
REPRODUCTION, OR DISTRIBUTION  
OF THIS DOCUMENT, ALONG WITH  
THE IDEAS AND DESIGN CONTAINED  
HEREIN, IS PROHIBITED UNLESS  
AUTHORIZED IN WRITING BY  
GARVER, LLC OR EXPLICITLY  
ALLOWED IN THE GOVERNING  
PROFESSIONAL SERVICES  
AGREEMENT FOR THIS WORK.

REV.	DATE	DESCRIPTION	BY
1	6/6/23	ADDENDUM NO. 2	AMJ



ANDREWS COUNTY  
AIRPORT  
ANDREWS, TEXAS

RUNWAY 16 AND TAXIWAY A  
RECONSTRUCTION

TAXIWAY A CROSS  
SECTIONS 3


JOB NO.: 22A11972  
DATE: JAN 2023  
DESIGNED BY: JAH  
DRAWN BY: JAH

BAR IS ONE INCH ON  
ORIGINAL DRAWING  
IF NOT ONE INCH ON THIS SHEET,  
ADJUST SCALES ACCORDINGLY.


DRAWING NUMBER  
**XS-203**

SHEET  
NUMBER **145**


File: L:\2022\22A11972 - E11 RW 16-34 and TW A Recon\Drawings\REFIE\11\_RW16-CAF-XSEC-TWA-20SCALE.dwg, Last Saved: 6/6/2023 9:49 AM, Last saved by: JAHenderson  
Last plotted by: Henderson, James, A Plot Style: AECmono.ctb Plot Scale: 1:1 Plot Date: 6/6/2023 1:45 PM Plotter used: AutoCAD PDF (General Documentation).pc3

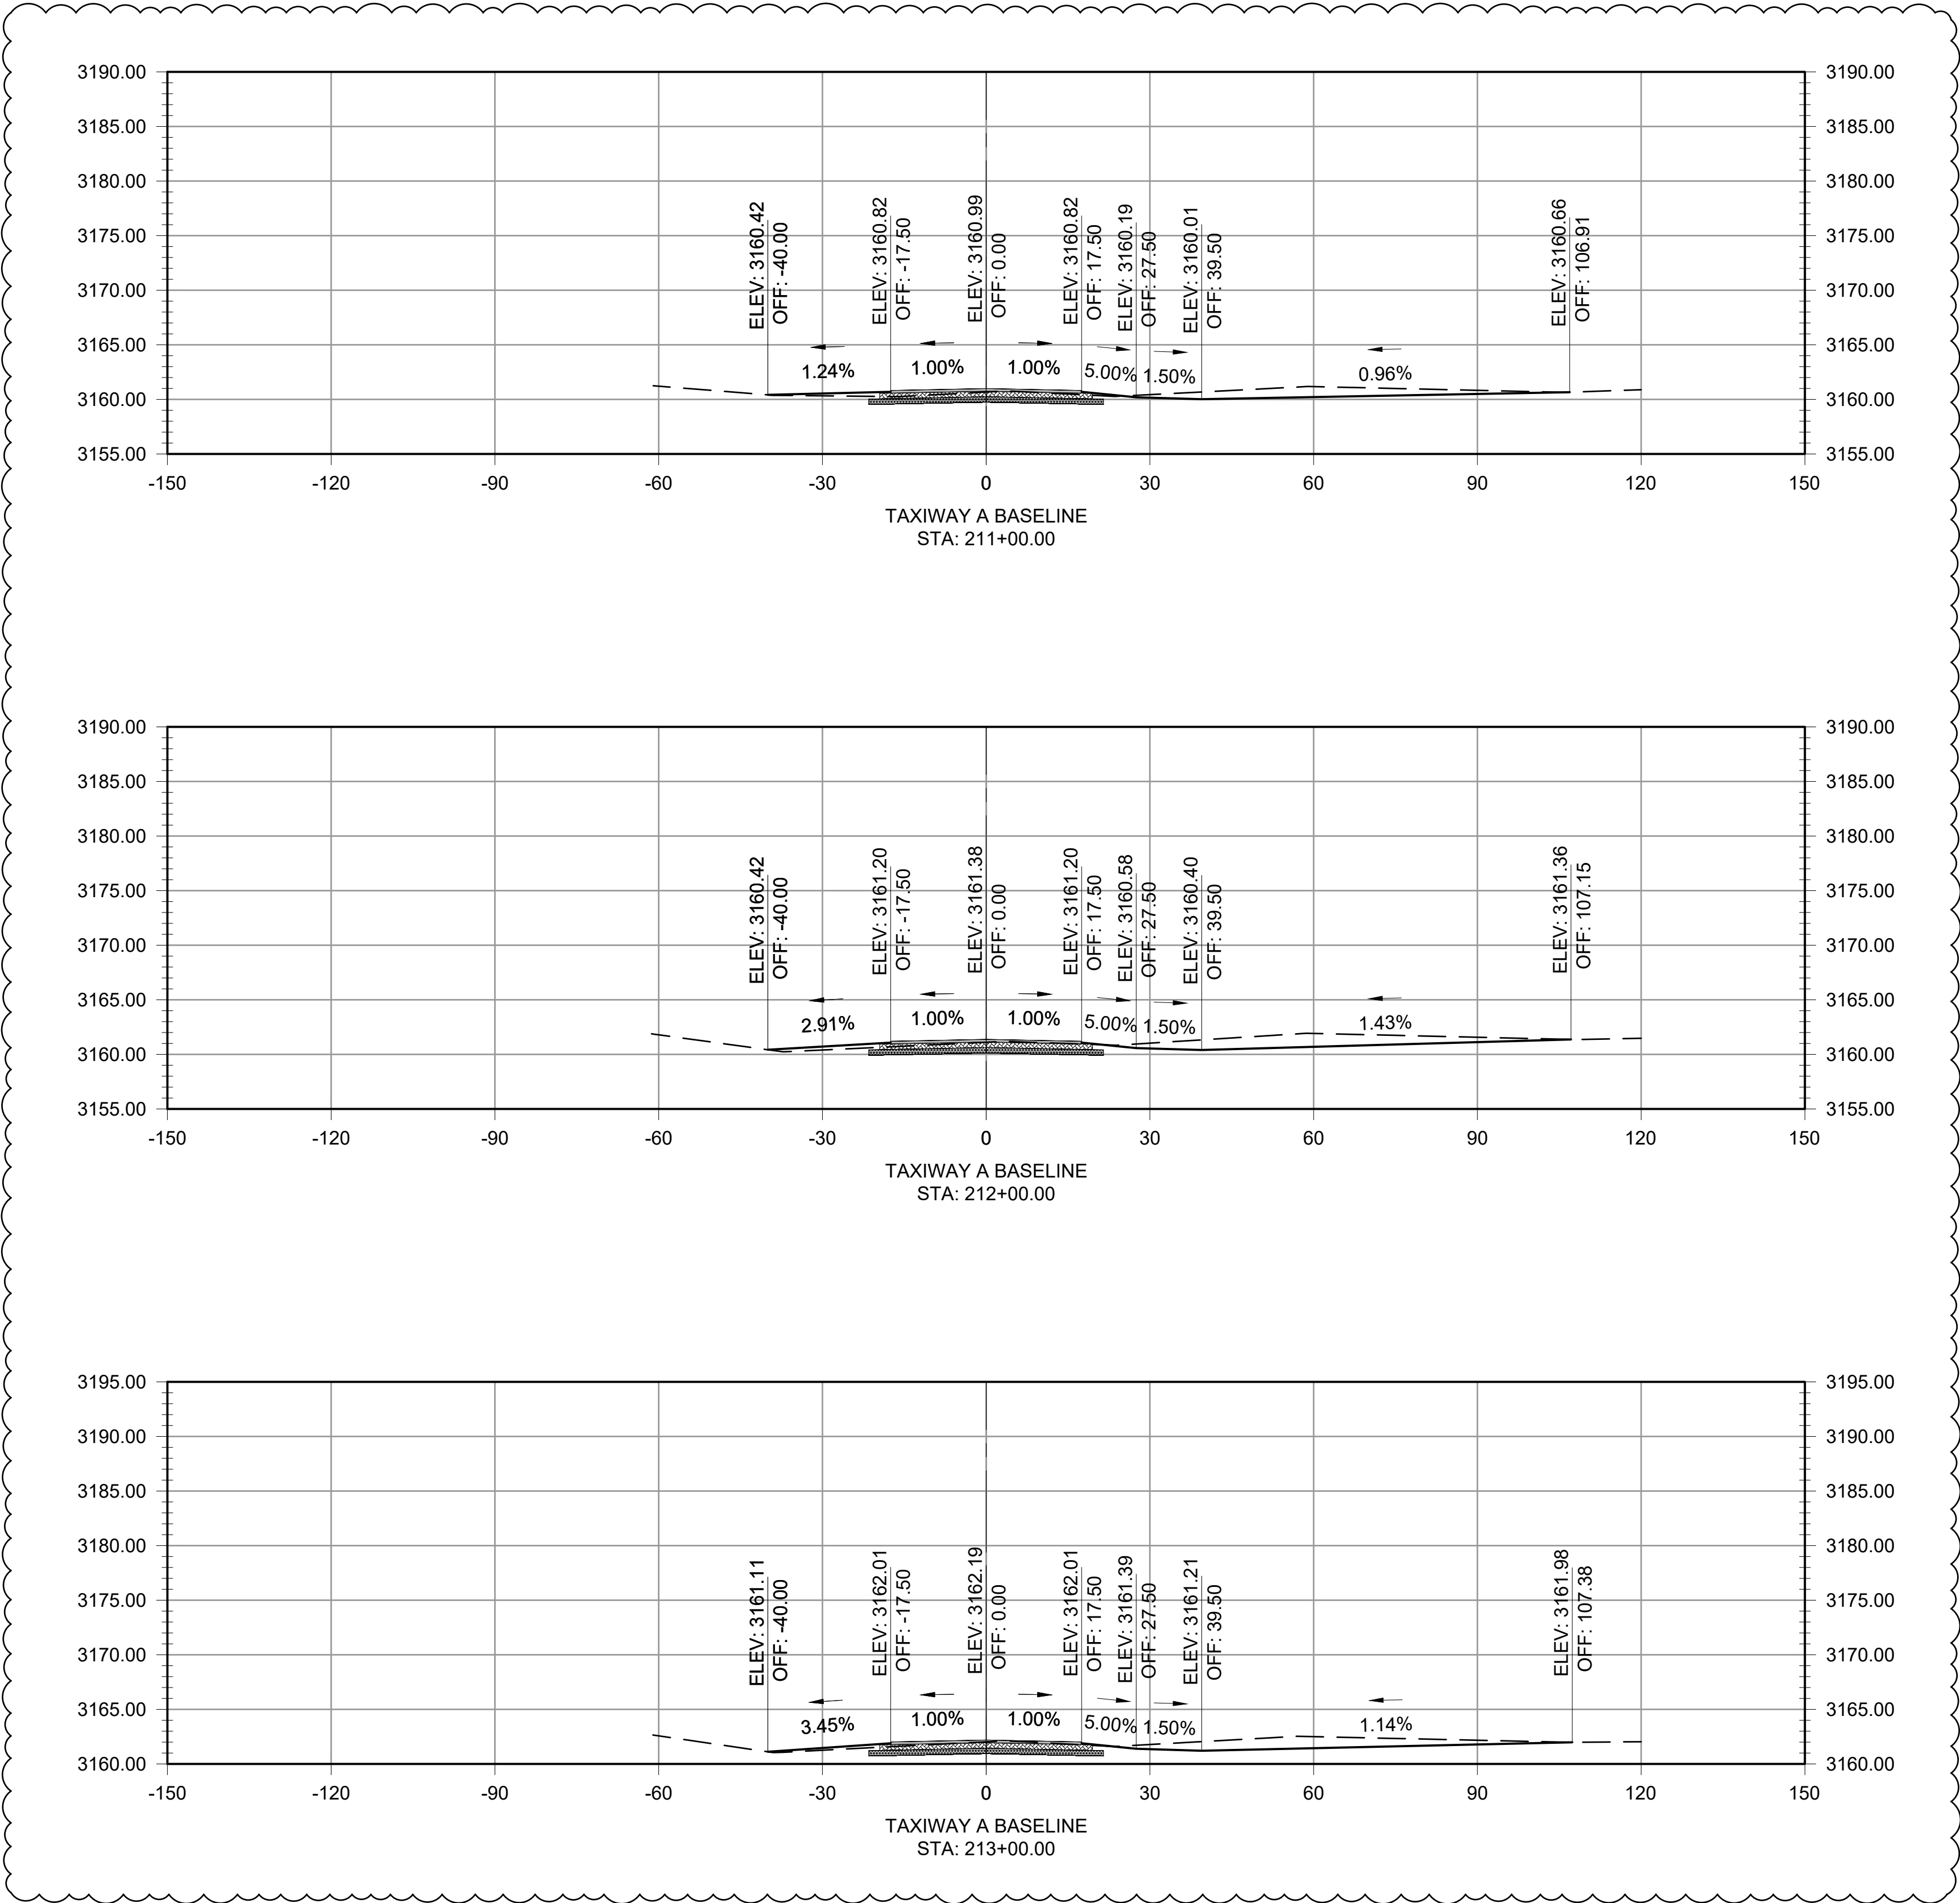

1

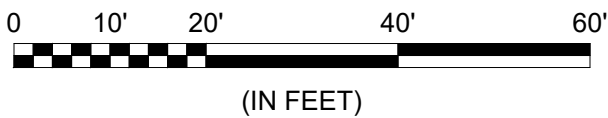


VERTICAL EXAGGERATION = 2



© 2023 GARVER, LLC  
THIS DOCUMENT, ALONG WITH THE IDEAS AND DESIGNS CONVEYED HEREIN, SHALL BE CONSIDERED INSTRUMENTS OF PROFESSIONAL SERVICE AND ARE PROPERTY OF GARVER, LLC. ANY USE, REPRODUCTION, OR DISTRIBUTION OF THIS DOCUMENT, ALONG WITH THE IDEAS AND DESIGN CONTAINED HEREIN, IS PROHIBITED UNLESS AUTHORIZED IN WRITING BY GARVER, LLC OR EXPLICITLY ALLOWED IN THE GOVERNING PROFESSIONAL SERVICES AGREEMENT FOR THIS WORK.

REV.	DATE	DESCRIPTION	BY
1	6/6/23	ADDENDUM NO. 2	AMJ



ANDREWS COUNTY  
AIRPORT  
ANDREWS, TEXAS

RUNWAY 16 AND TAXIWAY A  
RECONSTRUCTION

TAXIWAY A CROSS  
SECTIONS 4

JOB NO.: 22A11972  
DATE: JAN 2023  
DESIGNED BY: JAH  
DRAWN BY: JAH

BAR IS ONE INCH ON  
ORIGINAL DRAWING  
IF NOT ONE INCH ON THIS SHEET,  
ADJUST SCALES ACCORDINGLY.

DRAWING NUMBER  
**XS-204**  
SHEET  
NUMBER **146**